


# All Ripley Design Responses are in Green Text

Plotted By: Stephanie Hansen Layout: WALKWAY CLASSIFICATIONS Printed On: 5/8/2018 12:35 PM File Name: L-10 WALKWAYS.dwg

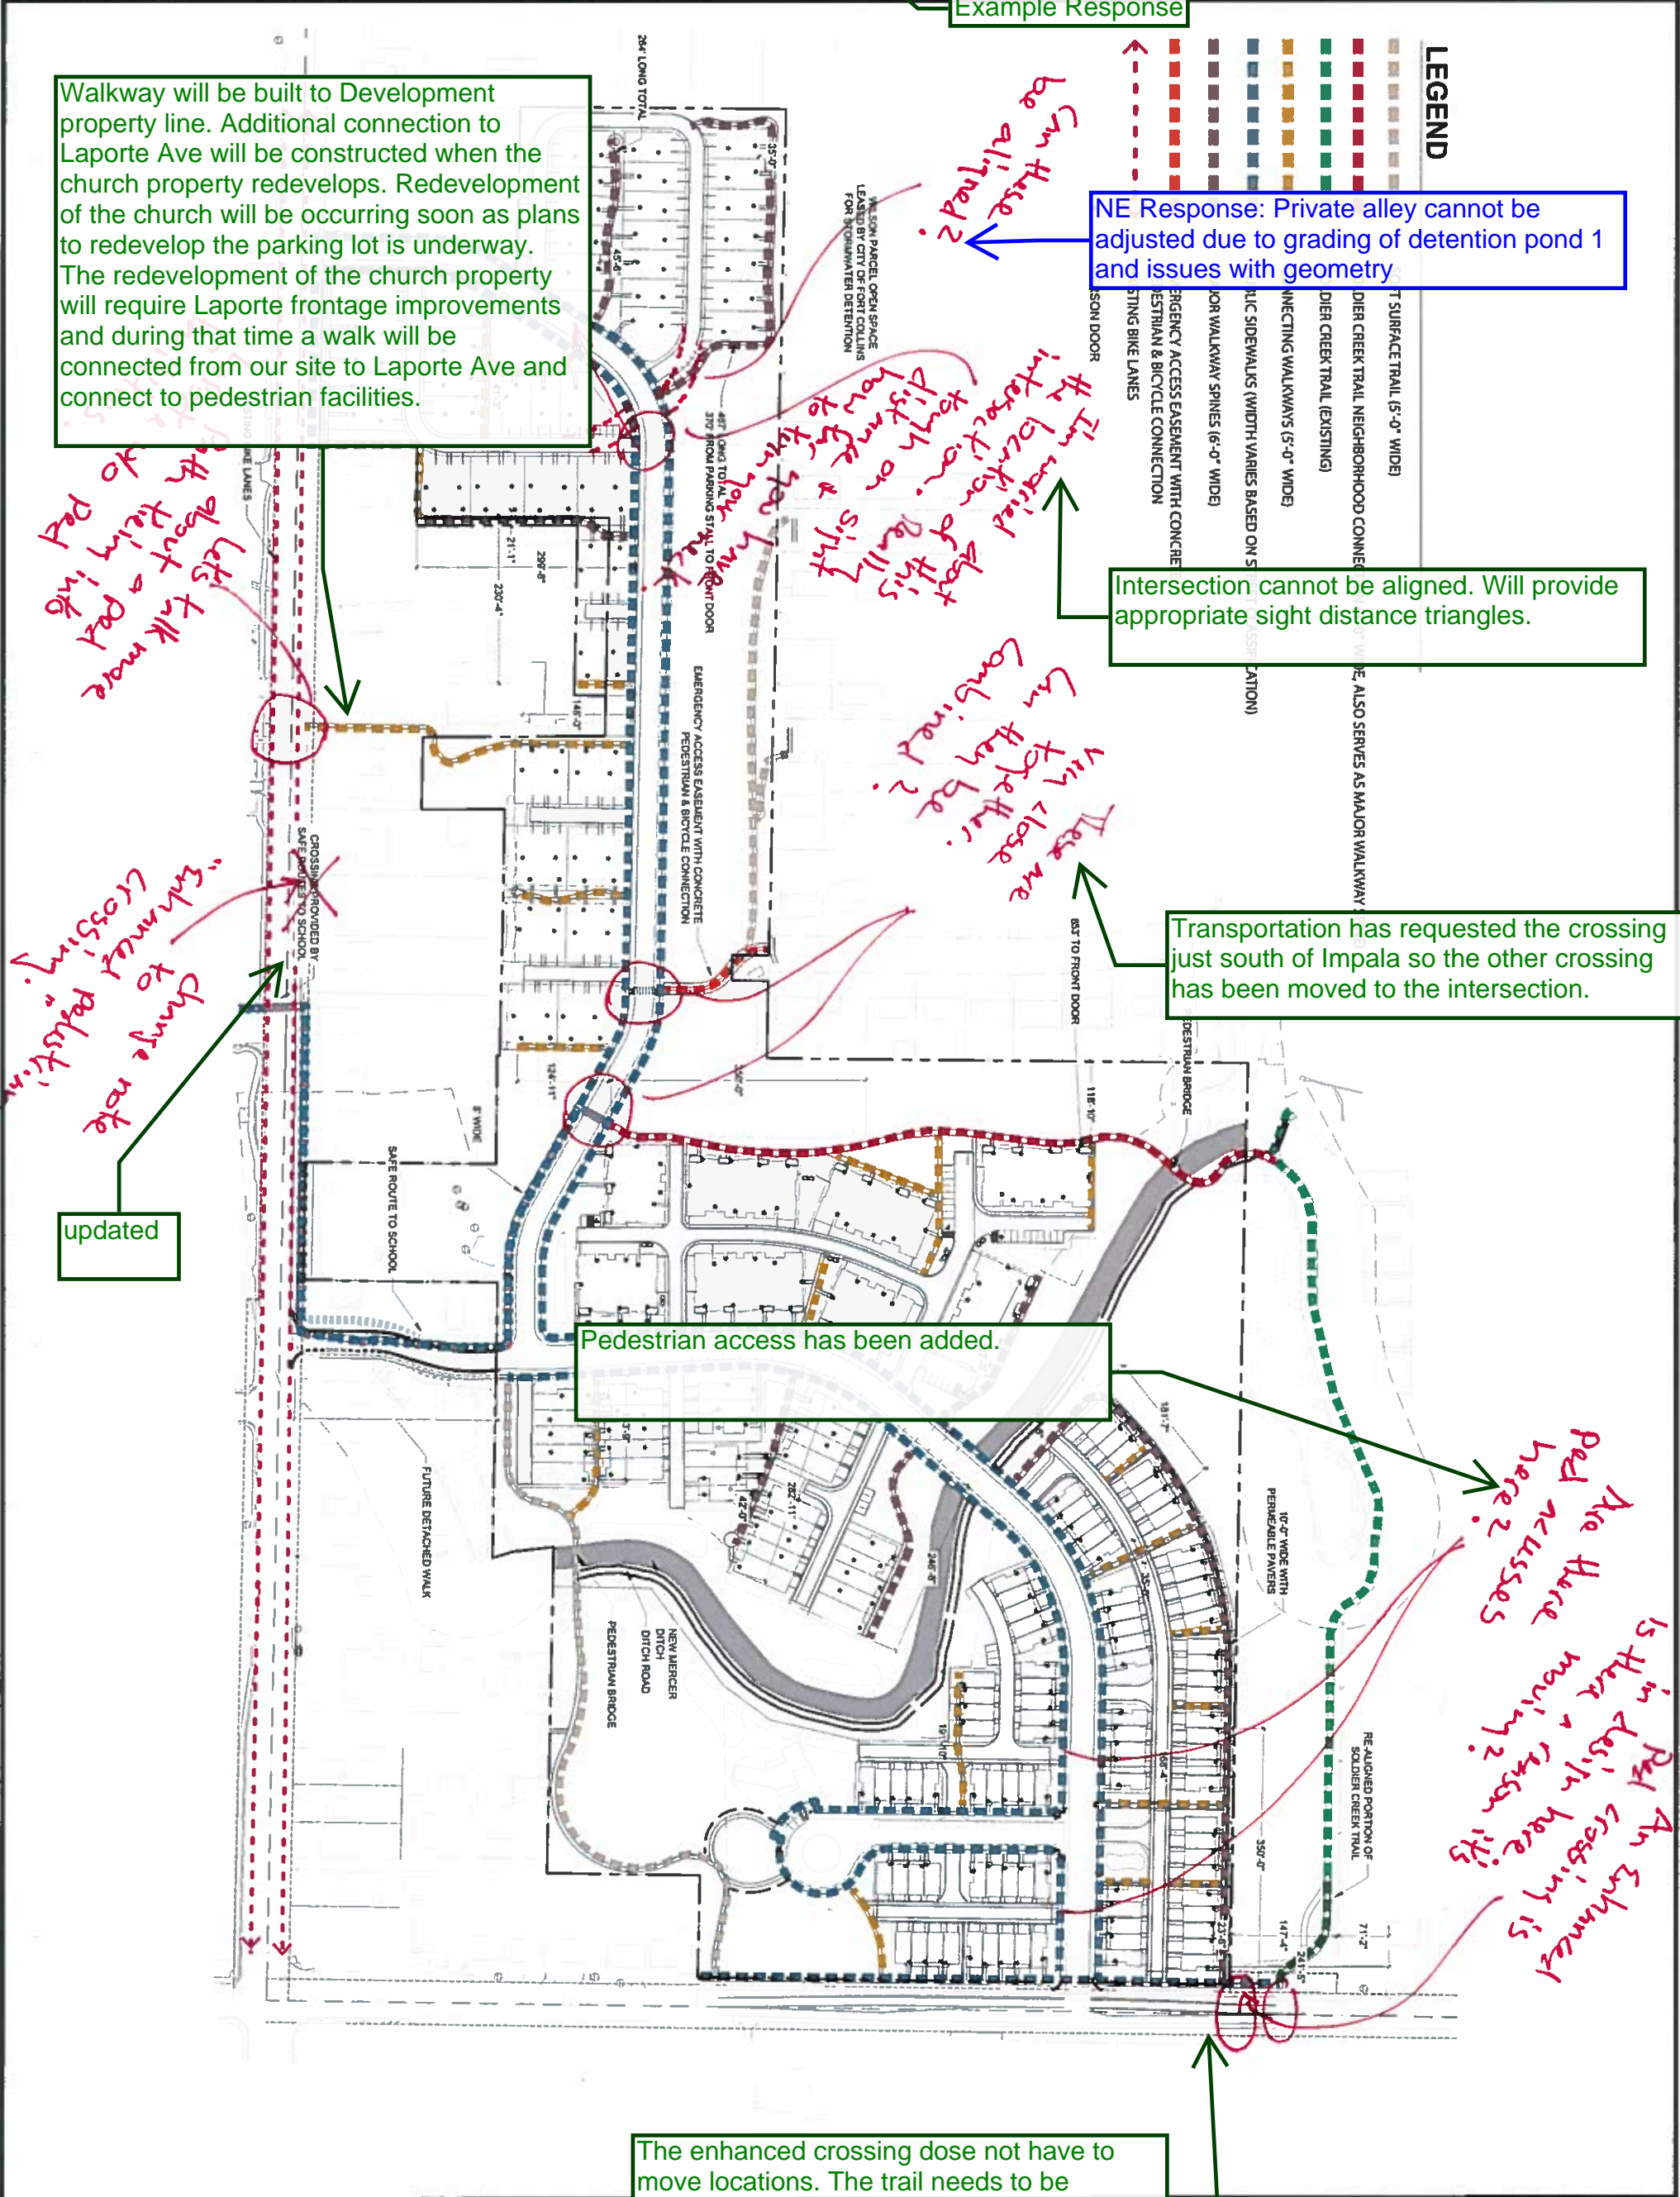

**PROJECT**  
SANCTUARY ON THE GREEN

**PROJECT DEVELOPMENT PLAN**

FOR TOWN OF FORT COLLINS, CO  
PREPARED BY:

**RIPLEY DESIGN INC.**

• hand planting a landscape architect •  
• urban design • settlement •  
4150 Canyon Ave, Suite 200 Fort Collins, CO 80521  
Phone: 970.225.8881 Fax: 970.225.8877 Email: info@ripleydesign.com

DATE: 5/1/2018  
DRAWN BY: JAH  
REVIEWED BY: SH  
DRAWING NUMBER: L-2 OF 32

**WALKWAY CLASSIFICATIONS**

REVISIONS

NO.	DESCRIPTION	DATE
01	CITY COMMENTS	05/08/2018

SCALE: 1"=100'-0"

DATE: 5/1/2018

**Review Round 2**  
J. Holland 5-28-2019

PROJECT No.: R14-004  
DRAWN BY: JAH  
REVIEWED BY: SH  
DRAWING NUMBER: L-2 OF 32