

INTRAWEST

MINOR AMENDMENT

INTRAWEST

MINOR AMENDMENT

FORT COLLINS, CO
PREPARED BY:



land planning landscape architecture
urban design entitlement
419 Canyon Ave. Suite 200 Fort Collins, CO 80521
phone 970.224.5828 | fax 970.225.6657 | www.ripleydesigninc.com

LAND PLANNER

RIPLEY DESIGN INC.
419 Canyon Ave. Suite 200
Fort Collins, CO 80521
p. 970.224.5828
f. 970.225.6657

OWNER AND APPLICANT


Dave Sitzman
Sitzman-Mitchell & Co
p. 970.223.5500

ENGINEER

NORTHERN ENGINEERING
301 N HOWES STREET
SUITE 100
FORT COLLINS, CO 80521

VICINITY MAP

SCALE: NTS

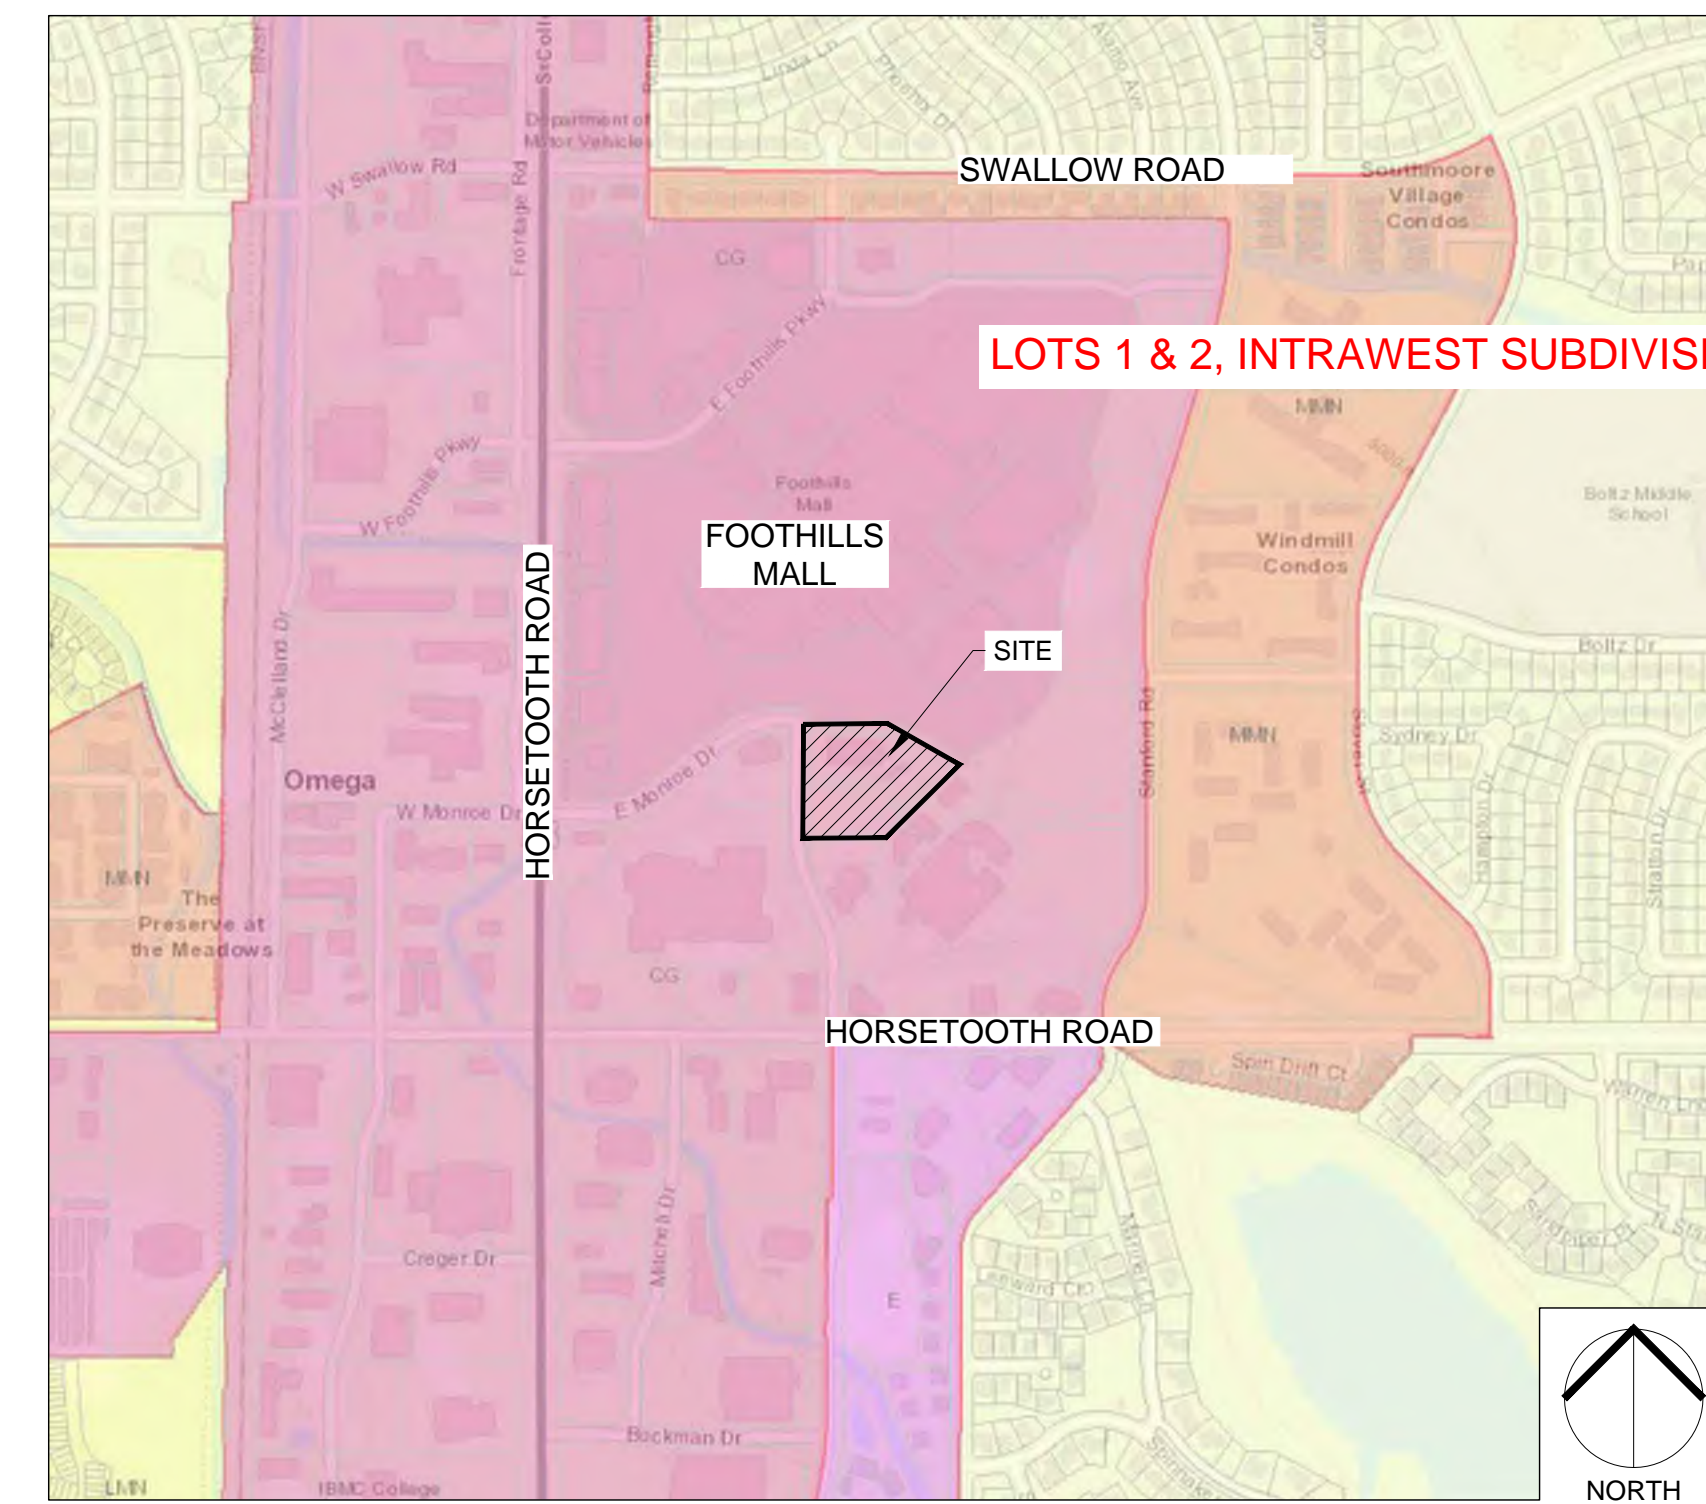

AMENDED PLANS

1. AMENDED ARENA MASTER PLAN
2. PUD

REFER TO INTRAWEST SUBDIVISION PLAT

LEGAL DESCRIPTION

A TRACT OF LAND BEING LOT 2 AND PART OF LOT 3, STRACHAN SUBDIVISION, THIRD FILING, AND PART OF TRACT 9, FOOTHILLS MALL EXPANSION, LOCATED IN THE SOUTHWEST QUARTER OF SECTION 25, TOWNSHIP 7 NORTH, RANGE 69 WEST OF THE 6TH P.M., CITY OF FORT COLLINS, COUNTY OF LARIMER, STATE OF COLORADO

Sheet List Table

Sheet Number	Sheet Title
L1.1	COVER
L2.1	AMENDED PUD
L3.1	LANDSCAPE PLANS
L3.2	LANDSCAPE DETAILS

ORIGINAL SIZE 24X36

ISSUED

No.	DESCRIPTION	DATE
1	MINOR AMENDMENT/BDR	10.17.2018
2	RESUBMITTAL	4.24.2019
3	MA REVISIONS	6.12.2019

REVISIONS

No.	DESCRIPTION	DATE

COVER

SEAL:



Reviewed By
**City Of Fort Collins
Technical Services**
Jac 6/25/19

PROJECT No.:	R18-041
DRAWN BY:	KR
REVIEWED BY:	LR
DRAWING NUMBER:	

L1.1 OF 4