


SPC

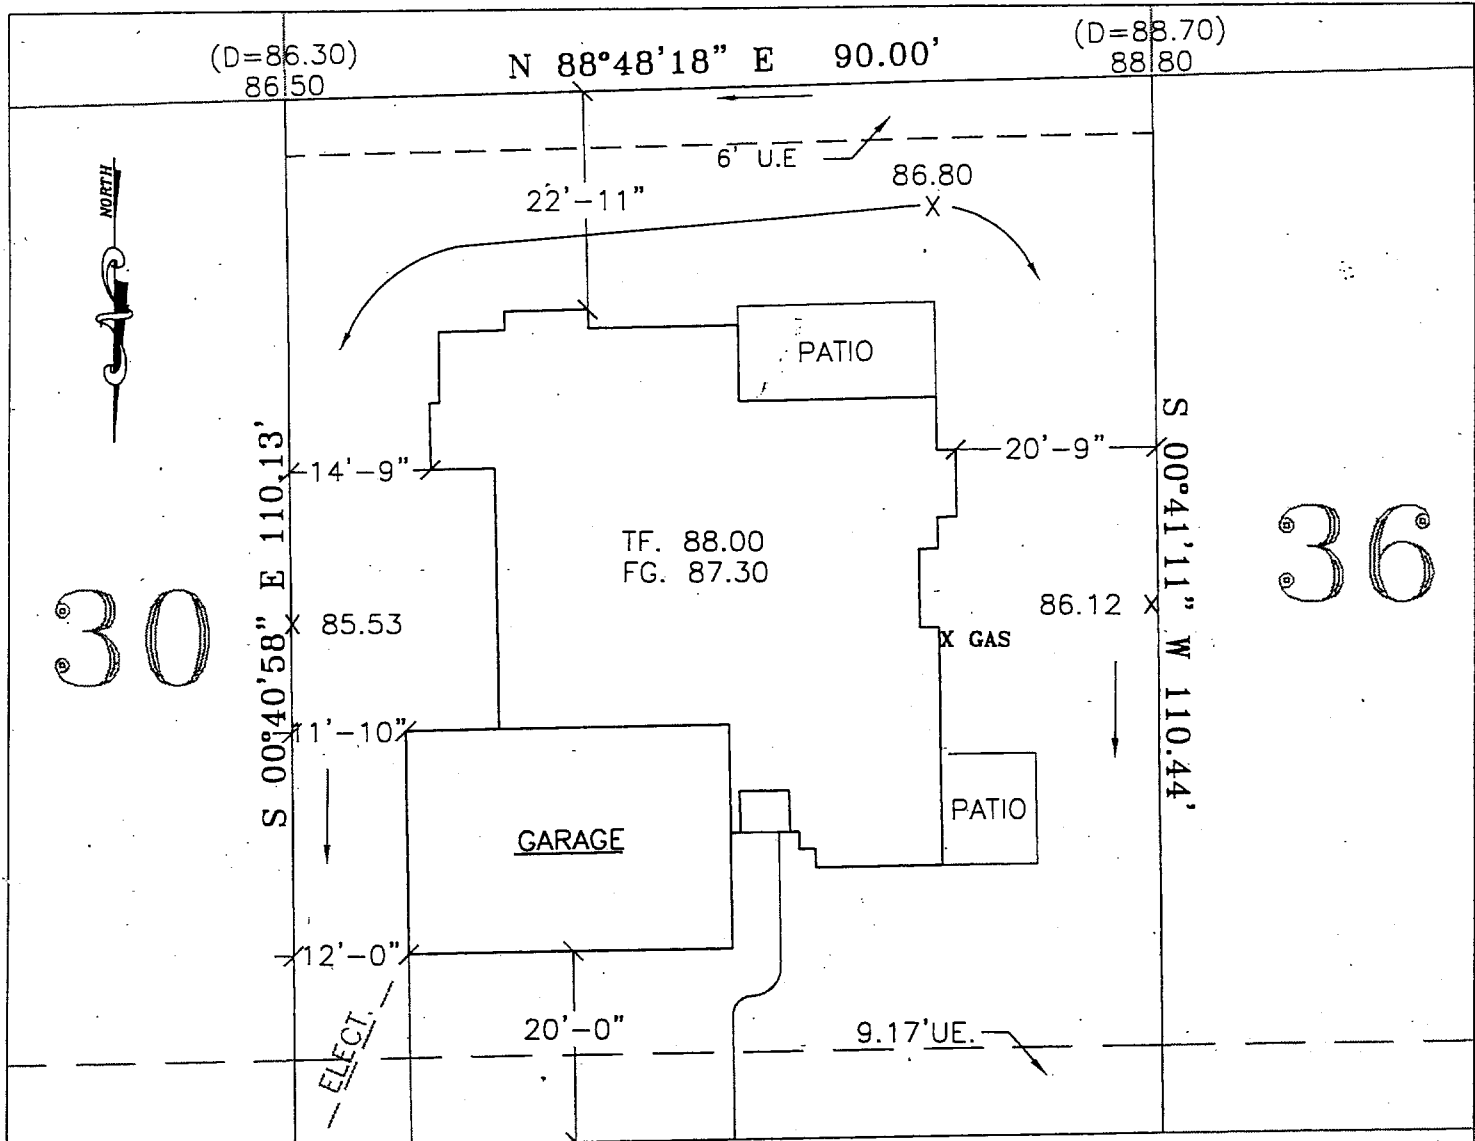

30

36

TF. 88.00
FG. 87.30

GARAGE

PATIO

PATIO

X GAS

X
84.56 @
5' OS.

X
85.44 @
5' OS.

B0405836

UE=DENOTES UTILITY EASEMENT
 (D=DESIGN ELEVATIONS)
 XX.XX = AS BUILT ELEVATIONS
 SCALE: 1"=20'-0"

PICARD LANE

09/03/04

Sp new 10.18.04 500-550 BTU

COTTONWOOD RIDGE SUB.
LOT 35 9,926 SQ.FT.
1157 PICARD LANE
FT. COLLINS CO. 80526

**PROGRESSIVE
 LIVING
 STRUCTURES
 INC.**

(970)669-0870
 4190 N. GARFIELD
 Hwy. 287 & E. 42nd
 LOVELAND, COLORADO
 80538

2-8-04