


K:\DENON\096501004_Mulberry_Connection\CADD\PlanSheets\CD\096501004_CD_UT_ELEC.dwg, Created: 08/01/2020 10:00 AM, Plot Date: 08/01/2020 10:00 AM
 THIS DOCUMENT, TOGETHER WITH THE CONCEPT AND DESIGN PRESENTED HEREIN, IS AN INSTRUMENT OF SERVICE. IT IS INTENDED ONLY FOR THE SPECIFIC PROJECT AND SITE FOR WHICH IT WAS PREPARED. REUSE OF, AND IMPROPER RELIANCE ON, THIS DOCUMENT WITHOUT WRITTEN AUTHORIZATION AND ADAPTATION BY KIMLEY-HORN AND ASSOCIATES, INC. SHALL BE WITHOUT LIABILITY TO KIMLEY-HORN AND ASSOCIATES, INC.

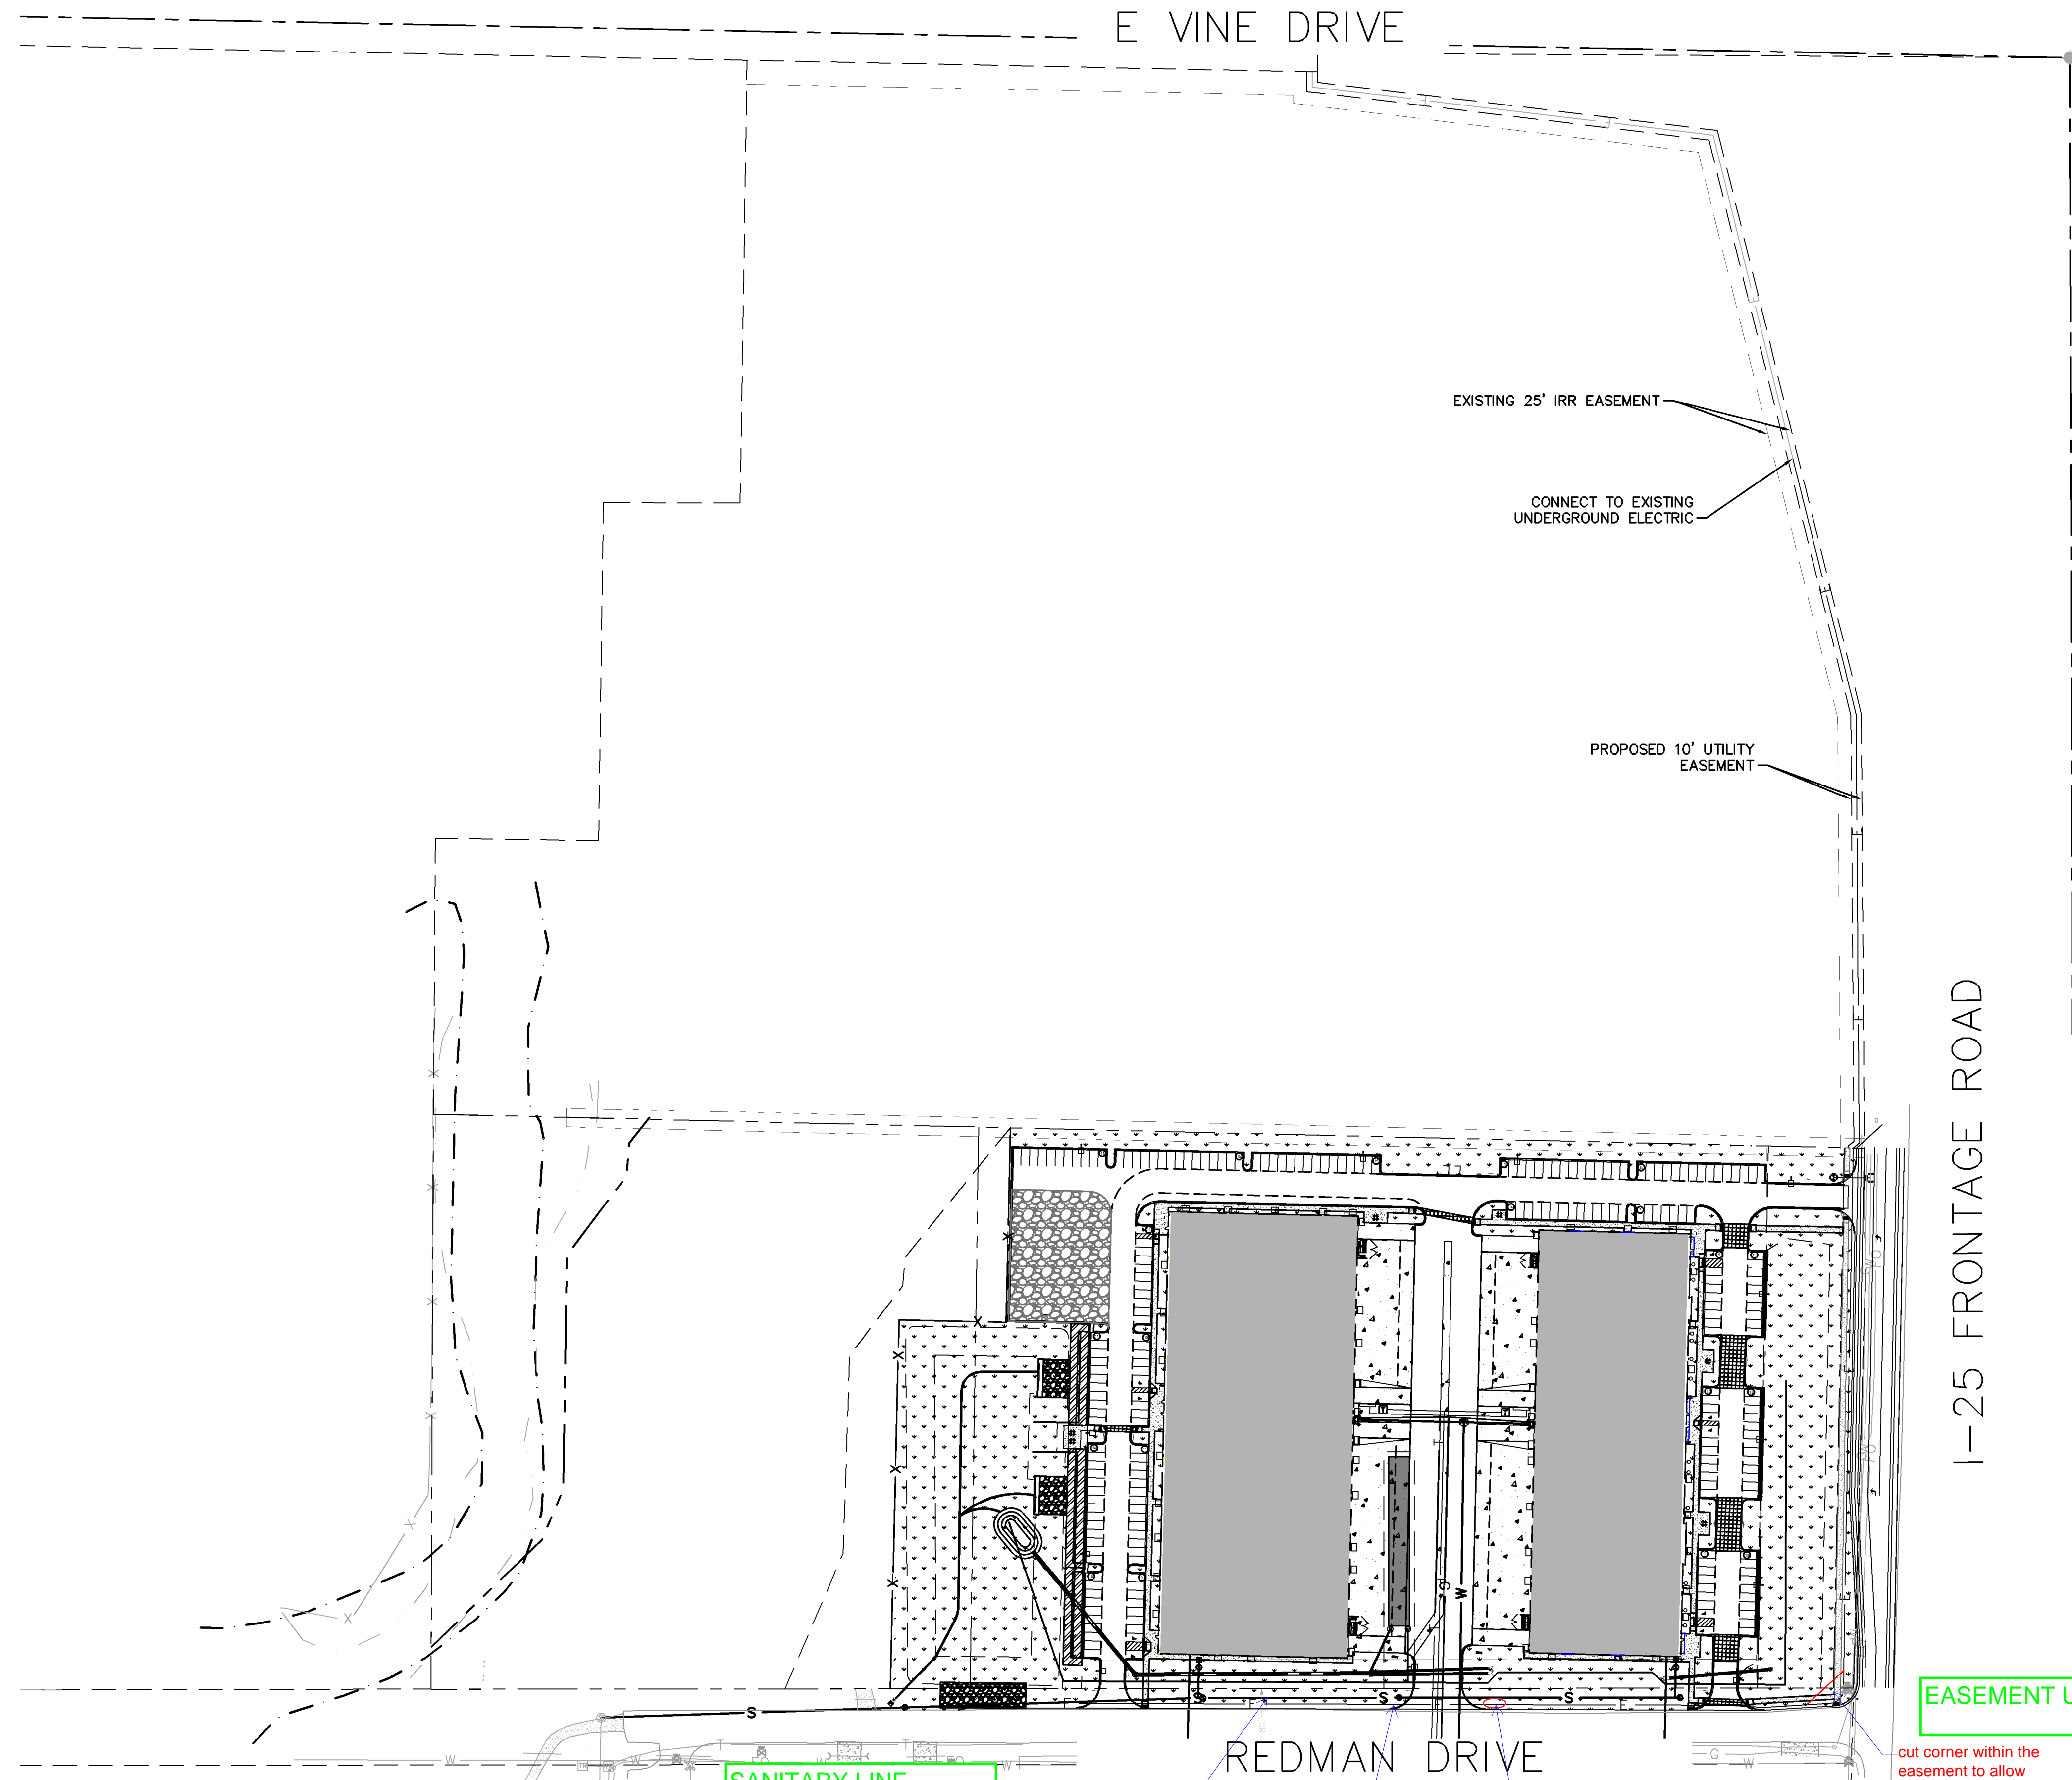

SANITARY LINE RELOCATED TO ENSURE SEPERATION

sanitary will need to be located within Redman Drive to allow adequate separation.

VAULTS ADDED ALONG FRONTAGE ROAD. ELECTRIC LINE TO SITE WILL CONNECT FROM FRONTAGE

Proposed electric can be terminated at the vault. We just need space to install in the future after the vault.

VAULTS ADDED ALONG FRONTAGE ROAD. ELECTRIC LINE TO SITE WILL CONNECT FROM FRONTAGE

EASEMENT UPDATED

cut corner within the easement to allow for separation from the existing fire hydrant.

GRAPHIC SCALE IN FEET
0 50 100 200

NORTH

811 Know what's below. Call before you dig.

Kimley»Horn		NO.	BY	DATE	APPR
2020 KIMLEY-HORN AND ASSOCIATES, INC. 4582 South Ulster Street, Suite 1500 Denver, Colorado 80237, (303) 728-2300					
DESIGNED BY: STC DRAWN BY: MGN CHECKED BY: DLS DATE: 01/08/2020					
MULBERRY CONNECTION CITY OF FORT COLLINS PRELIMINARY DEVELOPMENT PLAN TEMPLATE					
PRELIMINARY FOR REVIEW ONLY NOT FOR CONSTRUCTION Kimley»Horn Kimley-Horn and Associates, Inc.					
PROJECT NO. 096501004					
DRAWING NAME 096501004_CD_UT_ELEC					