


W H A R M O N Y R D (EAST BOUND)

CORRECTED

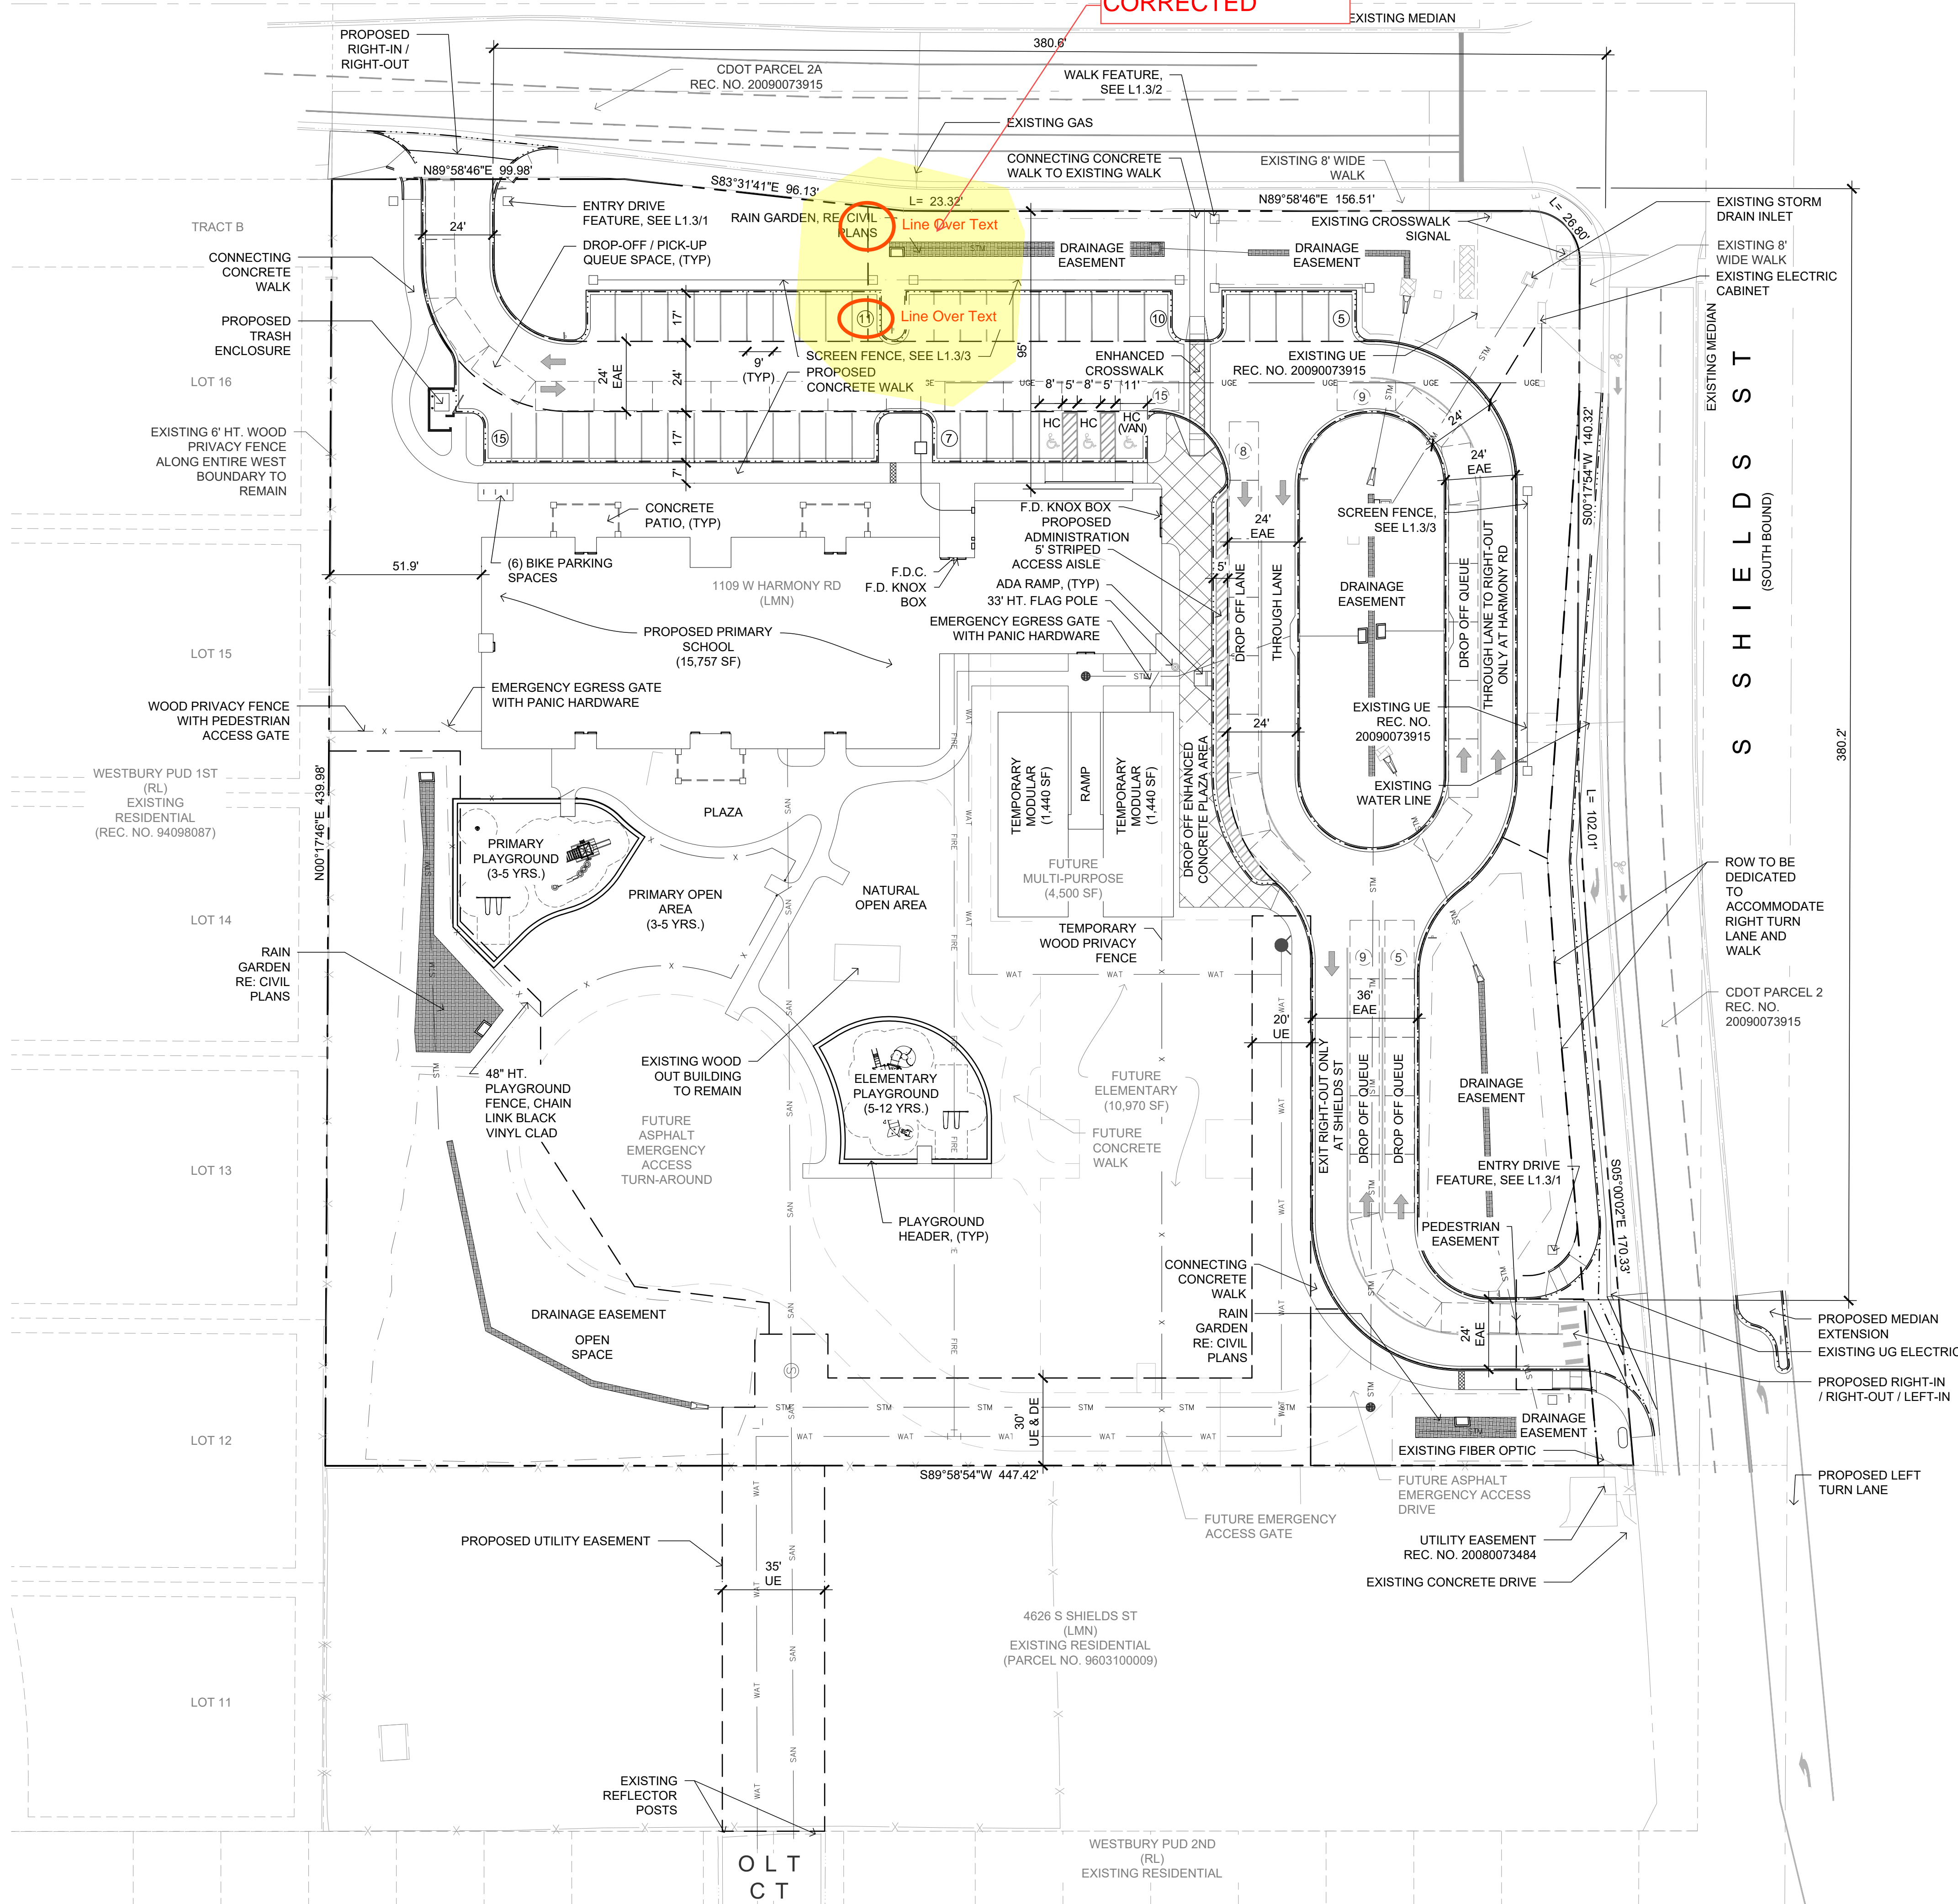


SITE PLAN ADVISORY REVIEW (SPAR) NOTES

1. FORT COLLINS MONTESSORI SCHOOL IS NOT REQUIRED TO COMPLY WITH REQUIREMENTS OF THE SITE PLAN NOTES. HOWEVER, TO THE EXTENT FEASIBLE AND WITHIN FORT COLLINS MONTESSORI SCHOOL BUDGET, IT WILL ENDEAVOR TO SATISFY SITE PLAN NOTE REQUIREMENTS.
2. SEE GENERAL SPAR NOTES ON SHEET L1.0

SITE PLAN NOTES

1. REFER TO FINAL UTILITY PLANS FOR EXACT LOCATIONS AND CONSTRUCTION INFORMATION FOR STORM DRAINAGE STRUCTURES, UTILITY MAINS AND SERVICES, PROPOSED TOPOGRAPHY, STREET IMPROVEMENTS.
2. REFER TO THE SUBDIVISION PLAT AND UTILITY PLANS FOR EXACT LOCATIONS, AREAS AND DIMENSIONS OF ALL EASEMENTS, LOTS, TRACTS, STREETS, WALKS AND OTHER SURVEY INFORMATION.
3. THE PROJECT SHALL BE CONSTRUCTED IN ACCORDANCE WITH THE FINAL PLANS. AMENDMENTS TO THE PLANS MUST BE REVIEWED AND APPROVED BY THE CITY PRIOR TO THE IMPLEMENTATION OF ANY CHANGES TO THE PLANS.
4. ALL ROOFTOP AND GROUND MOUNTED MECHANICAL EQUIPMENT MUST BE SCREENED FROM VIEW FROM ADJACENT PROPERTY AND PUBLIC STREETS. IN CASES WHERE BUILDING PARAPETS DO NOT ACCOMPLISH SUFFICIENT SCREENING, THEN FREE-STANDING SCREEN WALLS MATCHING THE PREDOMINANT COLOR OF THE BUILDING SHALL BE CONSTRUCTED. OTHER MINOR EQUIPMENT SUCH AS CONDUIT, METERS AND PLUMBING VENTS SHALL BE SCREENED OR PAINTED TO MATCH SURROUNDING BUILDING SURFACES.
5. ALL CONSTRUCTION WITH THIS DEVELOPMENT PLAN MUST BE COMPLETED IN ONE PHASE UNLESS A PHASING PLAN IS SHOWN WITH THESE PLANS.
6. [IF APPLICABLE -- INCLUDE LANGUAGE FOR ANY MODIFICATIONS AND CONDITIONS APPROVED WITH PDI/ODP].
7. ALL EXTERIOR LIGHTING PROVIDED SHALL COMPLY WITH THE FOOT-CANDLE REQUIREMENTS IN SECTION 3.2.4 OF THE LAND USE CODE AND SHALL USE A CONCEALED, FULLY SHIELDED LIGHT SOURCE WITH SHARP CUT-OFF CAPABILITY SO AS TO MINIMIZE UP-LIGHT, SPILL LIGHT, GLARE AND UNNECESSARY DIFFUSION.
8. SIGNAGE AND ADDRESSING ARE NOT PERMITTED WITH THIS PLANNING DOCUMENT AND MUST BE APPROVED BY SEPARATE CITY PERMIT PRIOR TO CONSTRUCTION. SIGNS MUST COMPLY WITH CITY SIGN CODE UNLESS A SPECIFIC VARIANCE IS GRANTED BY THE CITY.
9. FIRE HYDRANTS MUST MEET OR EXCEED Poudre FIRE AUTHORITY STANDARDS. ALL BUILDINGS MUST PROVIDE AN APPROVED FIRE EXTINGUISHING SYSTEM.
10. ALL BIKE RACKS PROVIDED MUST BE PERMANENTLY ANCHORED.
11. ALL SIDEWALKS AND RAMPS MUST CONFORM TO CITY STANDARDS. ACCESSIBLE RAMPS MUST BE PROVIDED AT ALL STREET AND DRIVE INTERSECTIONS AND AT ALL DESIGNATED ACCESSIBLE PARKING SPACES. ACCESSIBLE PARKING SPACES MUST SLOPE NO MORE THAN 1:48 IN ANY DIRECTION. ALL ACCESSIBLE ROUTES MUST SLOPE NO MORE THAN 1:20 IN DIRECTION OF TRAVEL AND WITH NO MORE THAN 1:48 CROSS SLOPE.
12. COMMON OPEN SPACE AREAS AND LANDSCAPING WITHIN RIGHT OF WAYS, STREET MEDIANS, AND TRAFFIC CIRCLES ADJACENT TO COMMON OPEN SPACE AREAS ARE REQUIRED TO BE MAINTAINED BY THE PROPERTY OWNER OF THE COMMON AREA. THE PROPERTY OWNER IS RESPONSIBLE FOR SNOW REMOVAL ON ALL ADJACENT STREET SIDEWALKS AND SIDEWALKS IN COMMON OPEN SPACE AREAS.
13. DESIGN AND INSTALLATION OF ALL PARKWAY/TREE LAWN AND MEDIAN AREAS IN THE RIGHT-OF-WAY SHALL BE IN ACCORDANCE WITH CITY STANDARDS. UNLESS OTHERWISE AGREED TO BY THE CITY WITH THE FINAL PLANS, ALL ONGOING MAINTENANCE OF SUCH AREAS IS THE RESPONSIBILITY OF THE OWNER/DEVELOPER.
14. THE PROPERTY OWNER FOR EACH RESIDENTIAL LOT IS RESPONSIBLE FOR SNOW REMOVAL ON ALL STREET SIDEWALKS ADJACENT TO EACH RESIDENTIAL LOT.
15. PRIVATE CONDITIONS, COVENANTS, AND RESTRICTIONS (CC&R'S), OR ANY OTHER PRIVATE RESTRICTIVE COVENANT IMPOSED ON LANDOWNERS WITHIN THE DEVELOPMENT, MAY NOT BE CREATED OR ENFORCED HAVING THE EFFECT OF PROHIBITING OR LIMITING THE INSTALLATION OF XERISCAPE LANDSCAPING, SOLAR/PHOTO-VOLTAIC COLLECTORS (IF MOUNTED FLUSH UPON ANY ESTABLISHED ROOF LINE), CLOTHES LINES (IF LOCATED IN BACK YARDS), ODOR-CONTROLLED COMPOST BINS, OR WHICH HAVE THE EFFECT OF REQUIRING THAT A PORTION OF ANY INDIVIDUAL LOT BE PLANTED IN TURF GRASS.
16. ANY DAMAGED CURB, GUTTER AND SIDEWALK EXISTING PRIOR TO CONSTRUCTION, AS WELL AS STREETS, SIDEWALKS, CURBS AND GUTTERS, DESTROYED, DAMAGED OR REMOVED DUE TO CONSTRUCTION OF THIS PROJECT, SHALL BE REPLACED OR RESTORED TO CITY OF FORT COLLINS STANDARDS AT THE DEVELOPER'S EXPENSE PRIOR TO THE ACCEPTANCE OF COMPLETED IMPROVEMENTS AND/OR PRIOR TO THE ISSUANCE OF THE FIRST CERTIFICATE OF OCCUPANCY.
17. FIRE LANE MARKING: A FIRE LANE MARKING PLAN MUST BE REVIEWED AND APPROVED BY THE FIRE OFFICIAL PRIOR TO THE ISSUANCE OF ANY CERTIFICATE OF OCCUPANCY. WHERE REQUIRED BY THE FIRE CODE OFFICIAL, APPROVED SIGNS OR OTHER APPROVED NOTICES THAT INCLUDE THE WORDS NO PARKING FIRE LANE SHALL BE PROVIDED FOR FIRE APPARATUS ACCESS ROADS TO IDENTIFY SUCH ROADS OR PROHIBIT THE OBSTRUCTION THEREOF. THE MEANS BY WHICH FIRE LANES ARE DESIGNATED SHALL BE MAINTAINED IN A CLEAN AND LEGIBLE CONDITION AT ALL TIMES AND BE REPLACED OR REPAIRED WHEN NECESSARY TO PROVIDE ADEQUATE VISIBILITY.
18. PREMISE IDENTIFICATION: AN ADDRESSING PLAN IS REQUIRED TO BE REVIEWED AND APPROVED BY THE CITY AND Poudre FIRE AUTHORITY PRIOR TO THE ISSUANCE OF ANY CERTIFICATE OF OCCUPANCY. UNLESS THE PRIVATE DRIVE IS NAMED, MONUMENT SIGNAGE MAY BE REQUIRED TO ALLOW WAY FINDING. ALL BUILDINGS SHALL HAVE ADDRESS NUMBERS, BUILDING NUMBERS OR APPROVED BUILDING IDENTIFICATION PLACED IN A POSITION THAT IS PLAINLY LEGIBLE, VISIBLE FROM THE STREET OR ROAD FRONTING THE PROPERTY, AND POSTED WITH A MINIMUM OF SIX INCH NUMERALS ON A CONTRASTING BACKGROUND, WHERE ACCESS IS BY MEANS OF A PRIVATE ROAD AND THE BUILDING CANNOT BE VIEWED FROM THE PUBLIC WAY, A MONUMENT, POLE OR OTHER SIGN OR MEANS SHALL BE USED TO IDENTIFY THE STRUCTURE

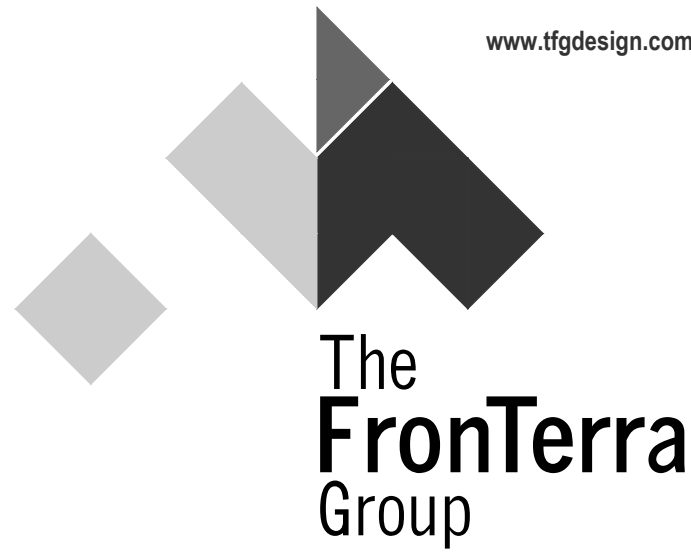

TFG Design, LLC
138 E 4th Street, STE #1
Loveland CO 80537
(970) 669-3737

OWNER:
Fort Collins Montessori School
Fort Collins, Colorado

FORT COLLINS MONTESSORI SCHOOL

SITE PLAN ADVISORY REVIEW

FORT COLLINS, COLORADO
LARIMER

PROJECT INFORMATION:
PROJECT NUMBER: 177-1902FC
DATE: OCT 16, 2019
PHASE: SPAR (FDP)

REVISIONS:
20200107 SPAR (FDP)
20200219 SPAR (FDP) 2ND SUBMITTAL

THIS DRAWING, AS AN INSTRUMENT OF SERVICE, IS AND SHALL REMAIN THE PROPERTY OF TFG DESIGN, LLC. THE FRONTERRA GROUP AND SHALL NOT BE REPRODUCED, PUBLISHED OR USED IN ANY WAY WITHOUT THE PERMISSION OF THE LANDSCAPE ARCHITECT.

SHEET TITLE:
SITE PLAN

SHEET NUMBER:
L1.1

SHEET 2 OF 13



Reviewed By
City Of Fort Collins
Technical Services
3/03/2020

SCALE
0