
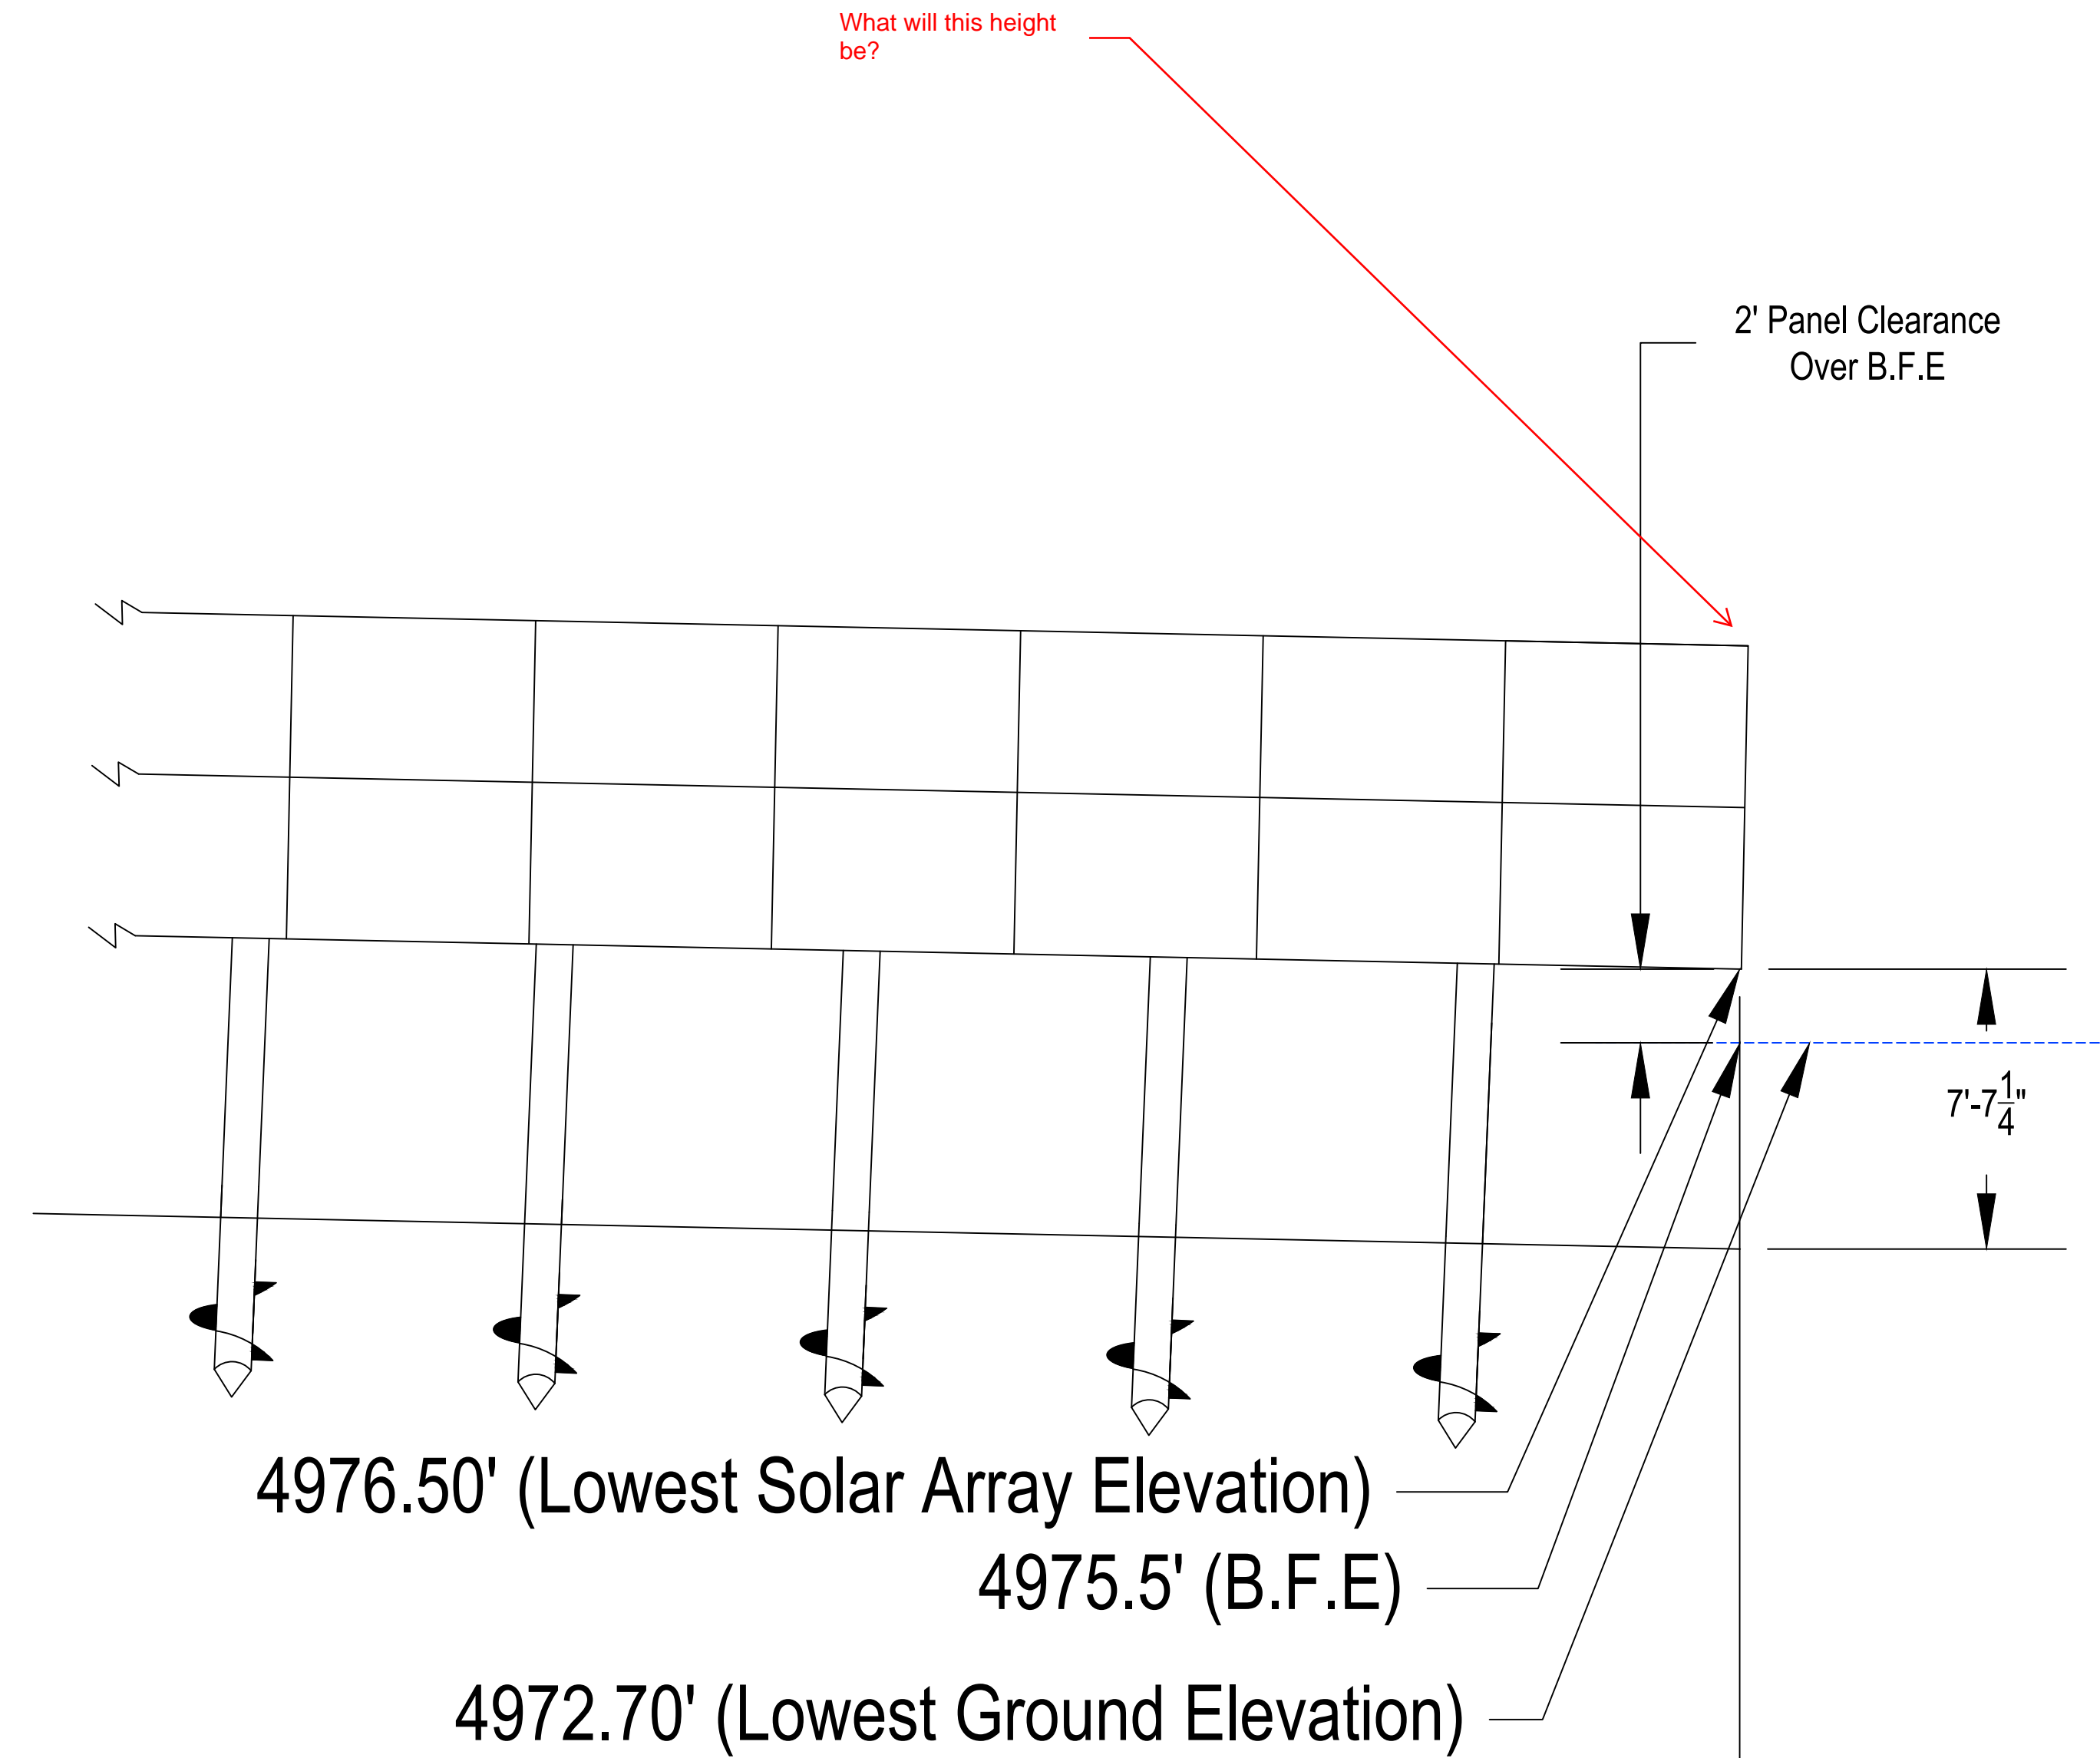


Page should be 24x36 for recording purposes.

GENERAL NOTES	
1	AVERAGE LAND SLOPE ~2.5%. (Min = 1.8%, Max = 3.3%)
2	ARRAY WILL MAINTAIN 3' CLEARANCE FROM BOTTOM EDGE OF SOLAR PANEL TO SURFACE
3	1' MINIMUM CLEARANCE OF THE SOLAR ARRAY TO THE BASE FLOOD ELEVATIONS.

3003

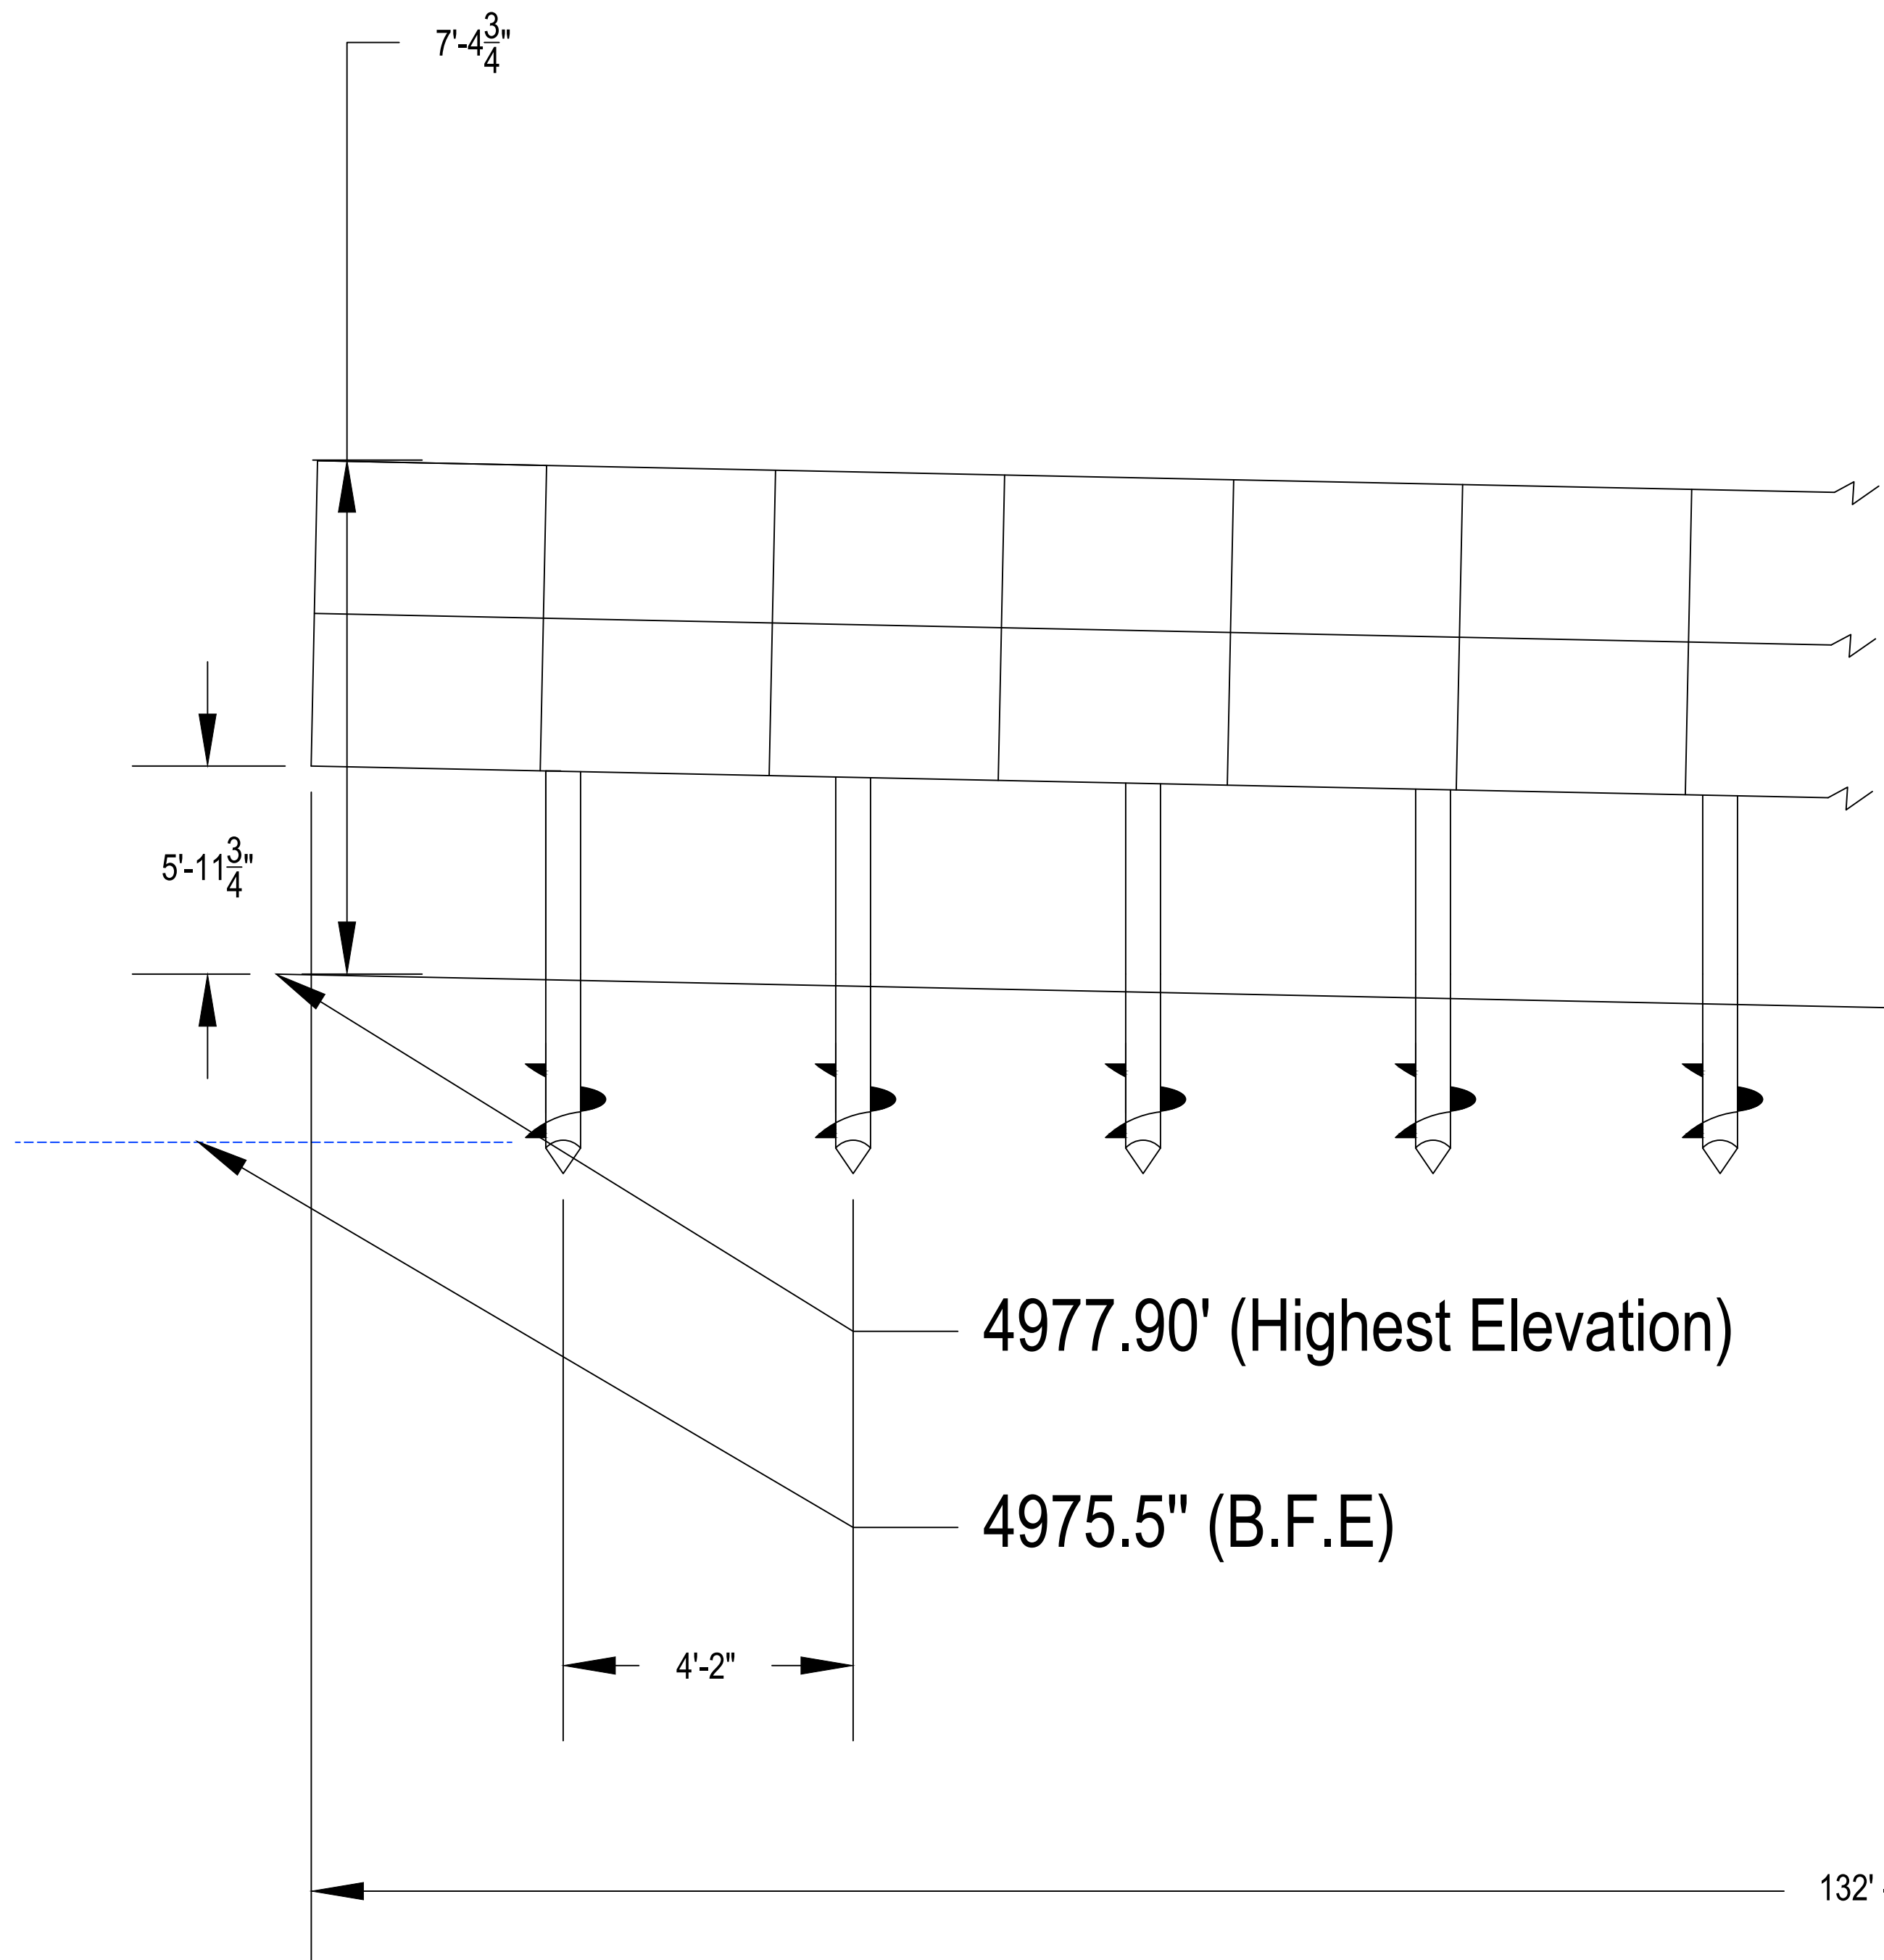

SP3 SMALL SCALE GRID-TIED PV SYSTEM

WATERGLEN SOLAR ARRAY
 Approx: 3730 CELTIC LN
 FORT COLLINS, CO 80524

ELEVATION

PROJECT ID: 99569

DATE: 12/20/18

CREATED BY: I.S.

CHECKED BY:

REVISIONS

1 Elevations
 FE-1 SCALE: 1/4" = 1'

E-1