


Page formatting should be 24x36. The plan set currently measures 22x34

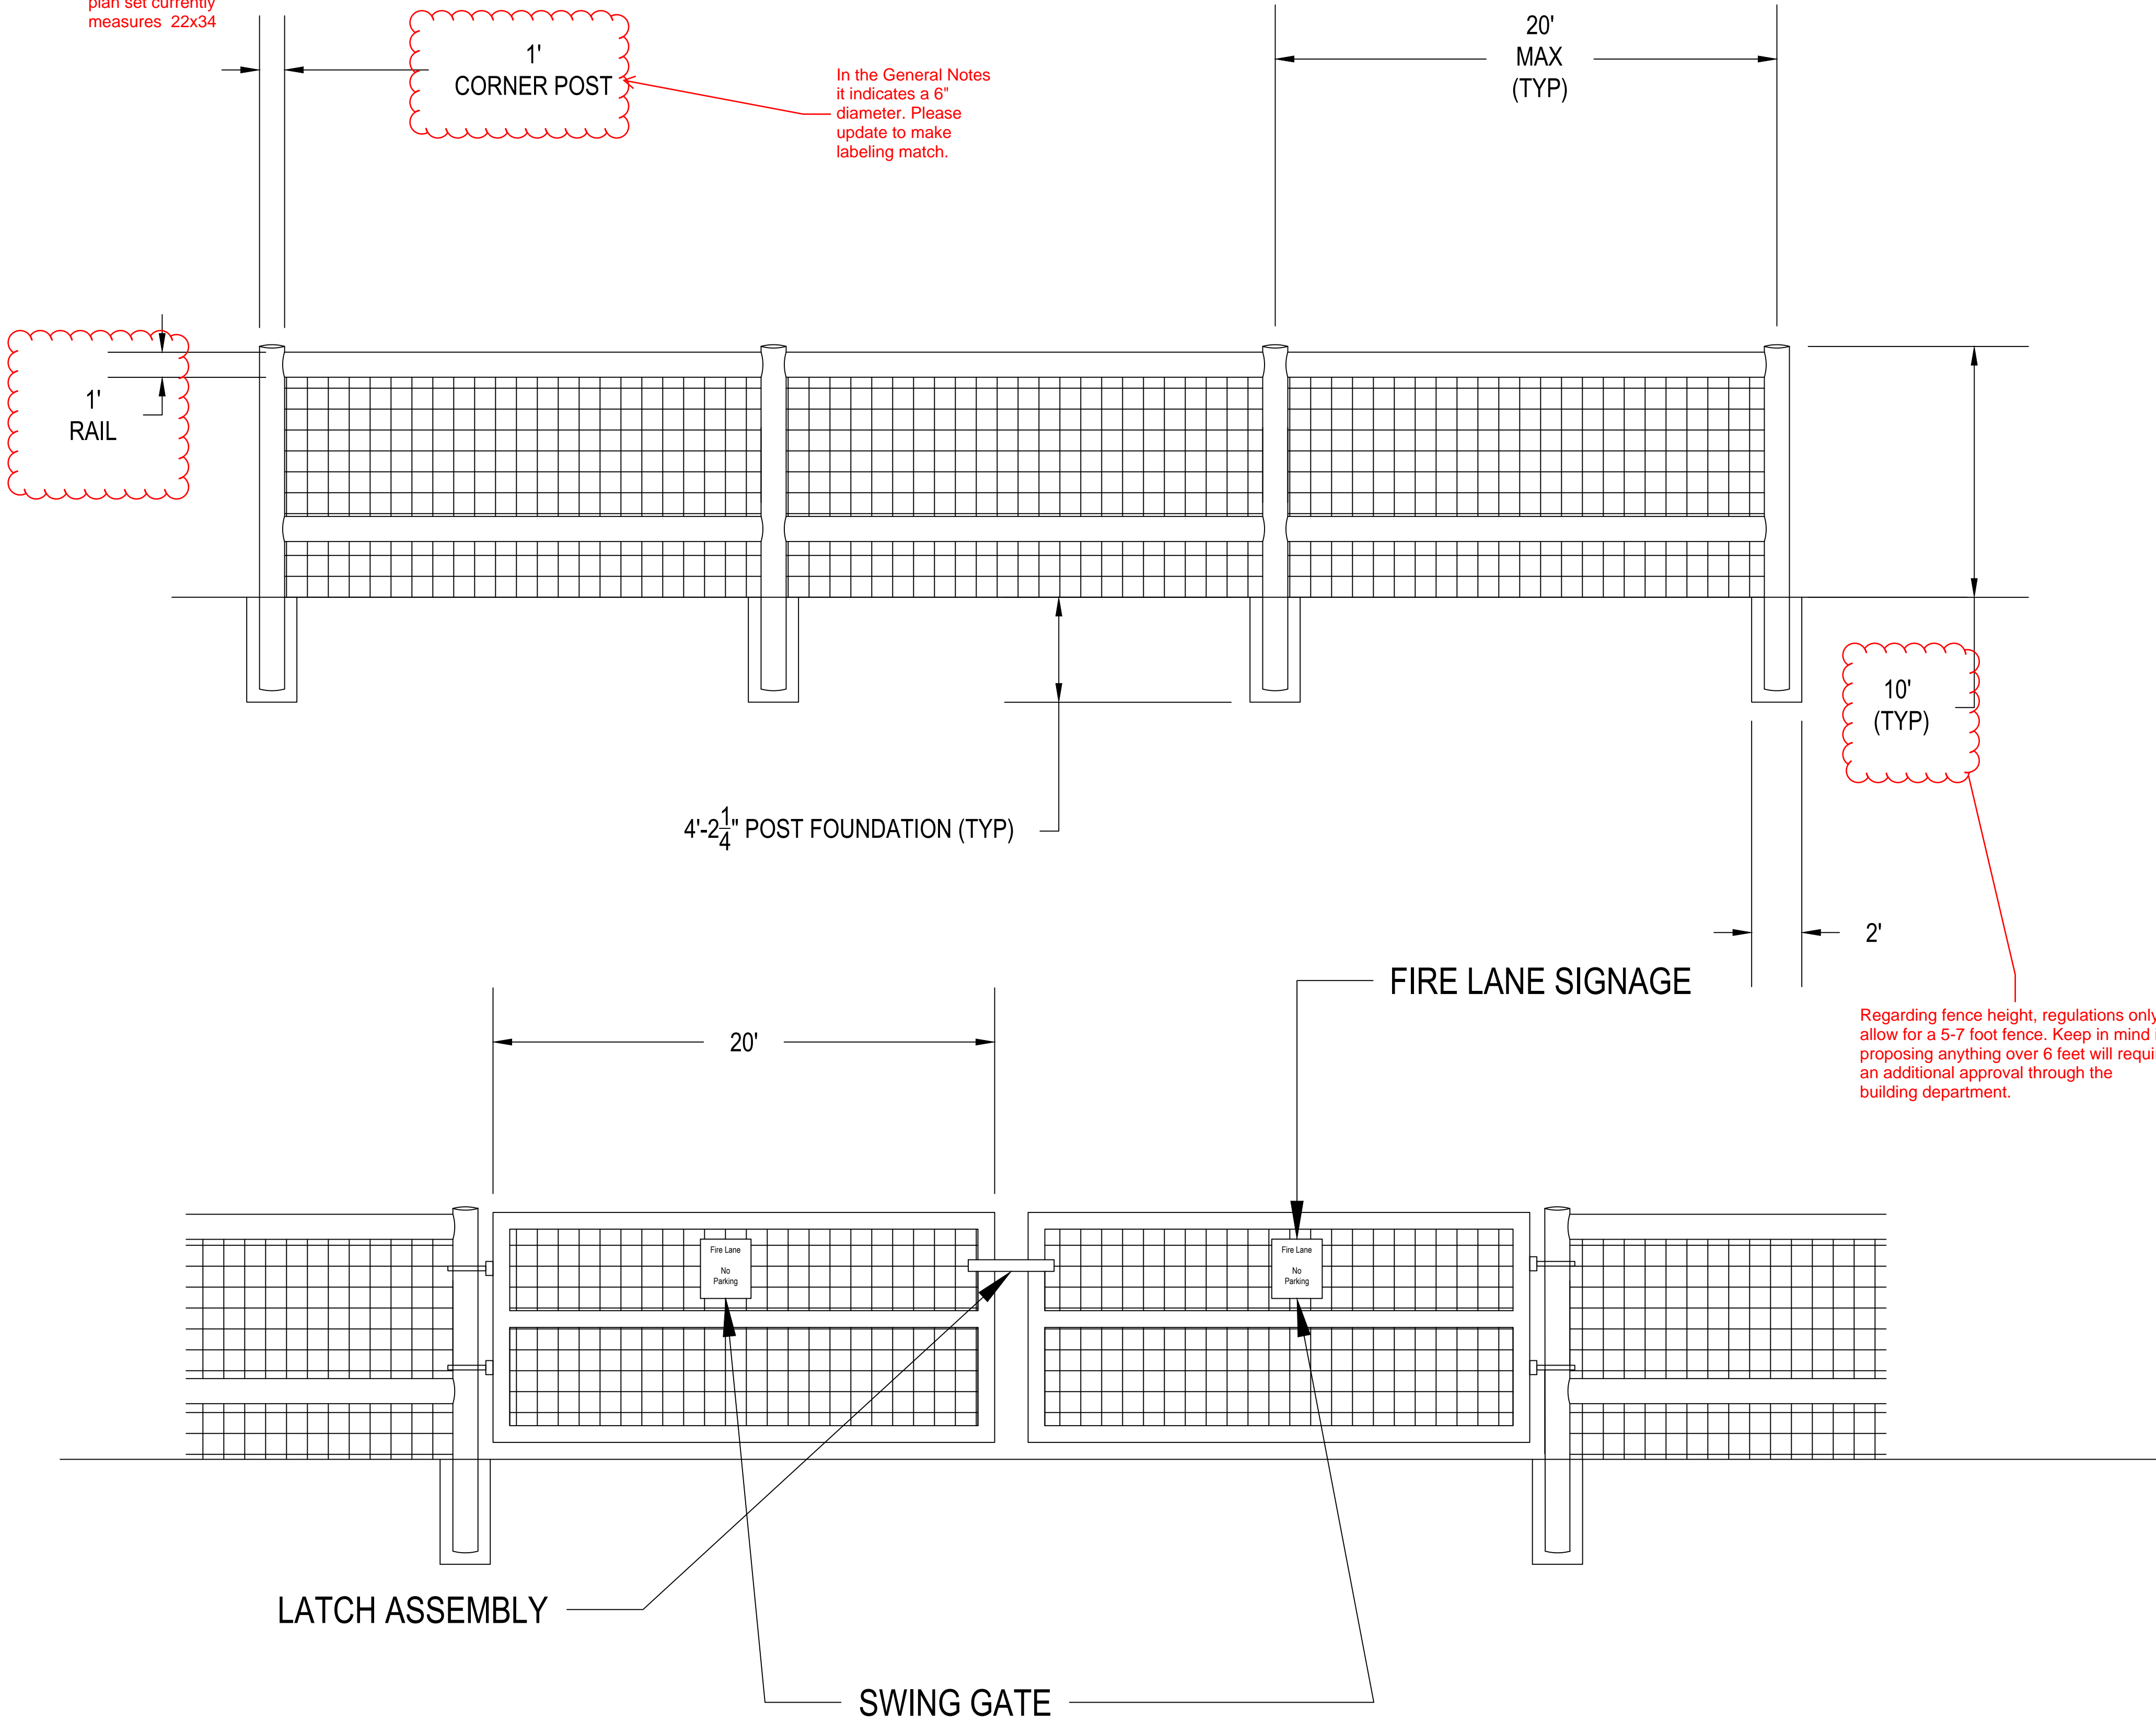

In the General Notes it indicates a 6" diameter. Please update to make labeling match.

10' (TYP)

Regarding fence height, regulations only allow for a 5-7 foot fence. Keep in mind if proposing anything over 6 feet will require an additional approval through the building department.

GENERAL NOTES	
1	FABRIC: 5' SQUARE WOVEN WIRE FENCE
2	ALL RAILS: PRESSURE TREATED, NATIVE TIMBER, 6" DIAMETER
3	STAPLES SHALL BE MINIMUM 1.5" U-TYPE, BARBED, FENCE WIRE SHALL BE STAPLED TO WOOD POSTS AND STAYS
4	FENCE WIRE MAY BE PLACED ON EITHER SIDE OF THE POSTS DEPENDING ON LOCAL CONDITIONS I.E. ON CURVES, THE WIRE SHOULD BE PLACED ON THE SIDE WHICH WOULD RESULT IN THE LEAST AMOUNT OF TENSION ON THE STAPLES.
	FENCE FABRIC SHALL CONFORM TO AASHTO M 279 (ASTM A 116)
	ALL FENCING, WIRE TIES, BRACES, AND STAPLES SHALL BE GALVANIZED IN CONFORMANCE WITH AASHTO M 232.
	FENCE NEAR FLOODWAY WILL BE STAKED AND SURVEYED SO THAT IT IS NOT WITHIN FLOODWAY. FENCE AREAS NEAREST FLOODWAY BOUNDARY WILL HAVE ANCHOR POINTS WITH BREAKAWAY STAPLES.
SIGNAGE NOTES	
1	FIRE LANE SIGNS POSTED ON SWING GATE" SIGNAGE PER LARIMER COUNTY URBAN AREA STREET STANDARDS
2	PROJECT ACCESS GATE & PERIMETER FENCE WILL COMPLY WITH WARNING SIGNAGE AND LABELING REQUIREMENTS OF ARTICLE 690 OF THE 2017 NEC.

1 FENCE DETAIL
FE-1 SCALE: 1/4" = 1'

3003

SP3 SMALL SCALE GRID-TIED PV SYSTEM

WATERGLEN SOLAR ARRAY
Approx: 3730 CELTIC LN
FORT COLLINS, CO 80524

FENCING

PROJECT ID: 99569
DATE: 12/20/18
CREATED BY: I.S.
CHECKED BY:

REVISIONS

FE-1