
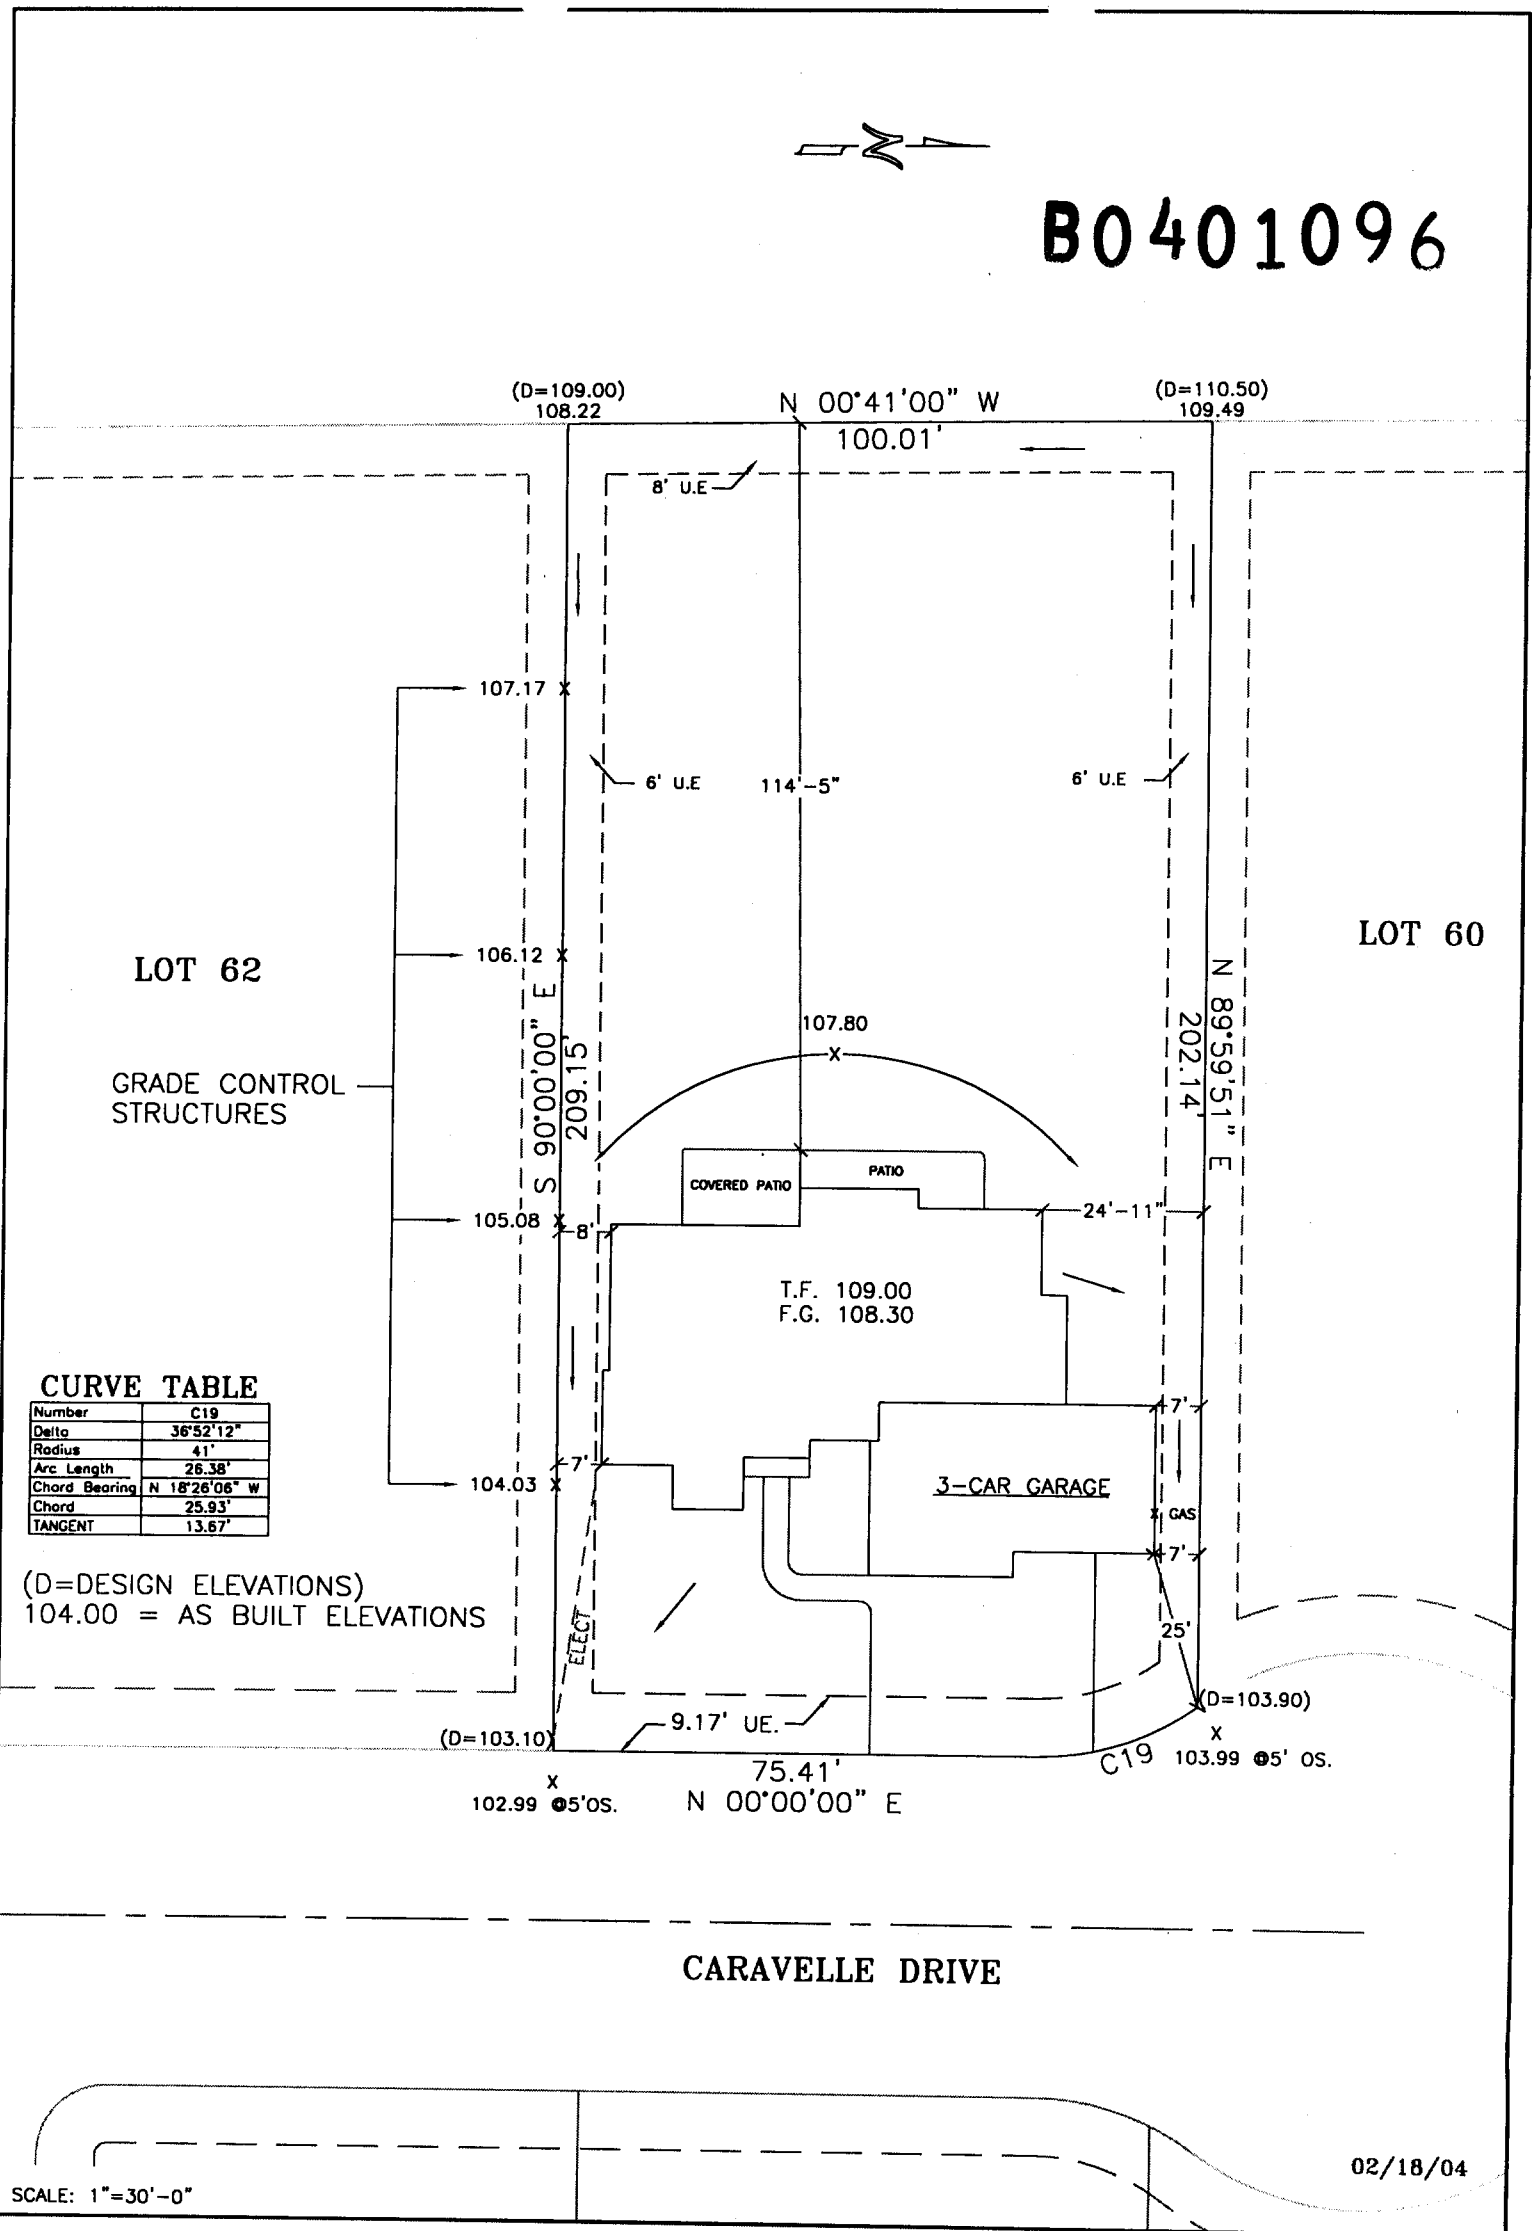


# B0401096

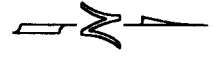

LOT 62

LOT 60

GRADE CONTROL STRUCTURES

COVERED PATIO

PATIO

T.F. 109.00  
F.G. 108.30

3-CAR GARAGE

CARAVELLE DRIVE

**CURVE TABLE**

Number	C19
Delta	36°52'12"
Radius	41'
Arc Length	26.38'
Chord Bearing	N 18°26'06" W
Chord	25.93'
TANGENT	13.67'

(D=DESIGN ELEVATIONS)  
104.00 = AS BUILT ELEVATIONS

SCALE: 1"=30'-0"

02/18/04

COTTONWOOD RIDGE SUB.  
LOT 61 20,911 SQ.FT.  
4815 CARAVELLE DR.

**LE JARDIN**  
SF NEW 3-15-04

PROGRESSIVE LIVING STRUCTURES INC.  
(970)669-0670  
4190 N. GARFIELD  
Hwy. 287 & E. 42nd  
LOVELAND, COLORADO 80538