
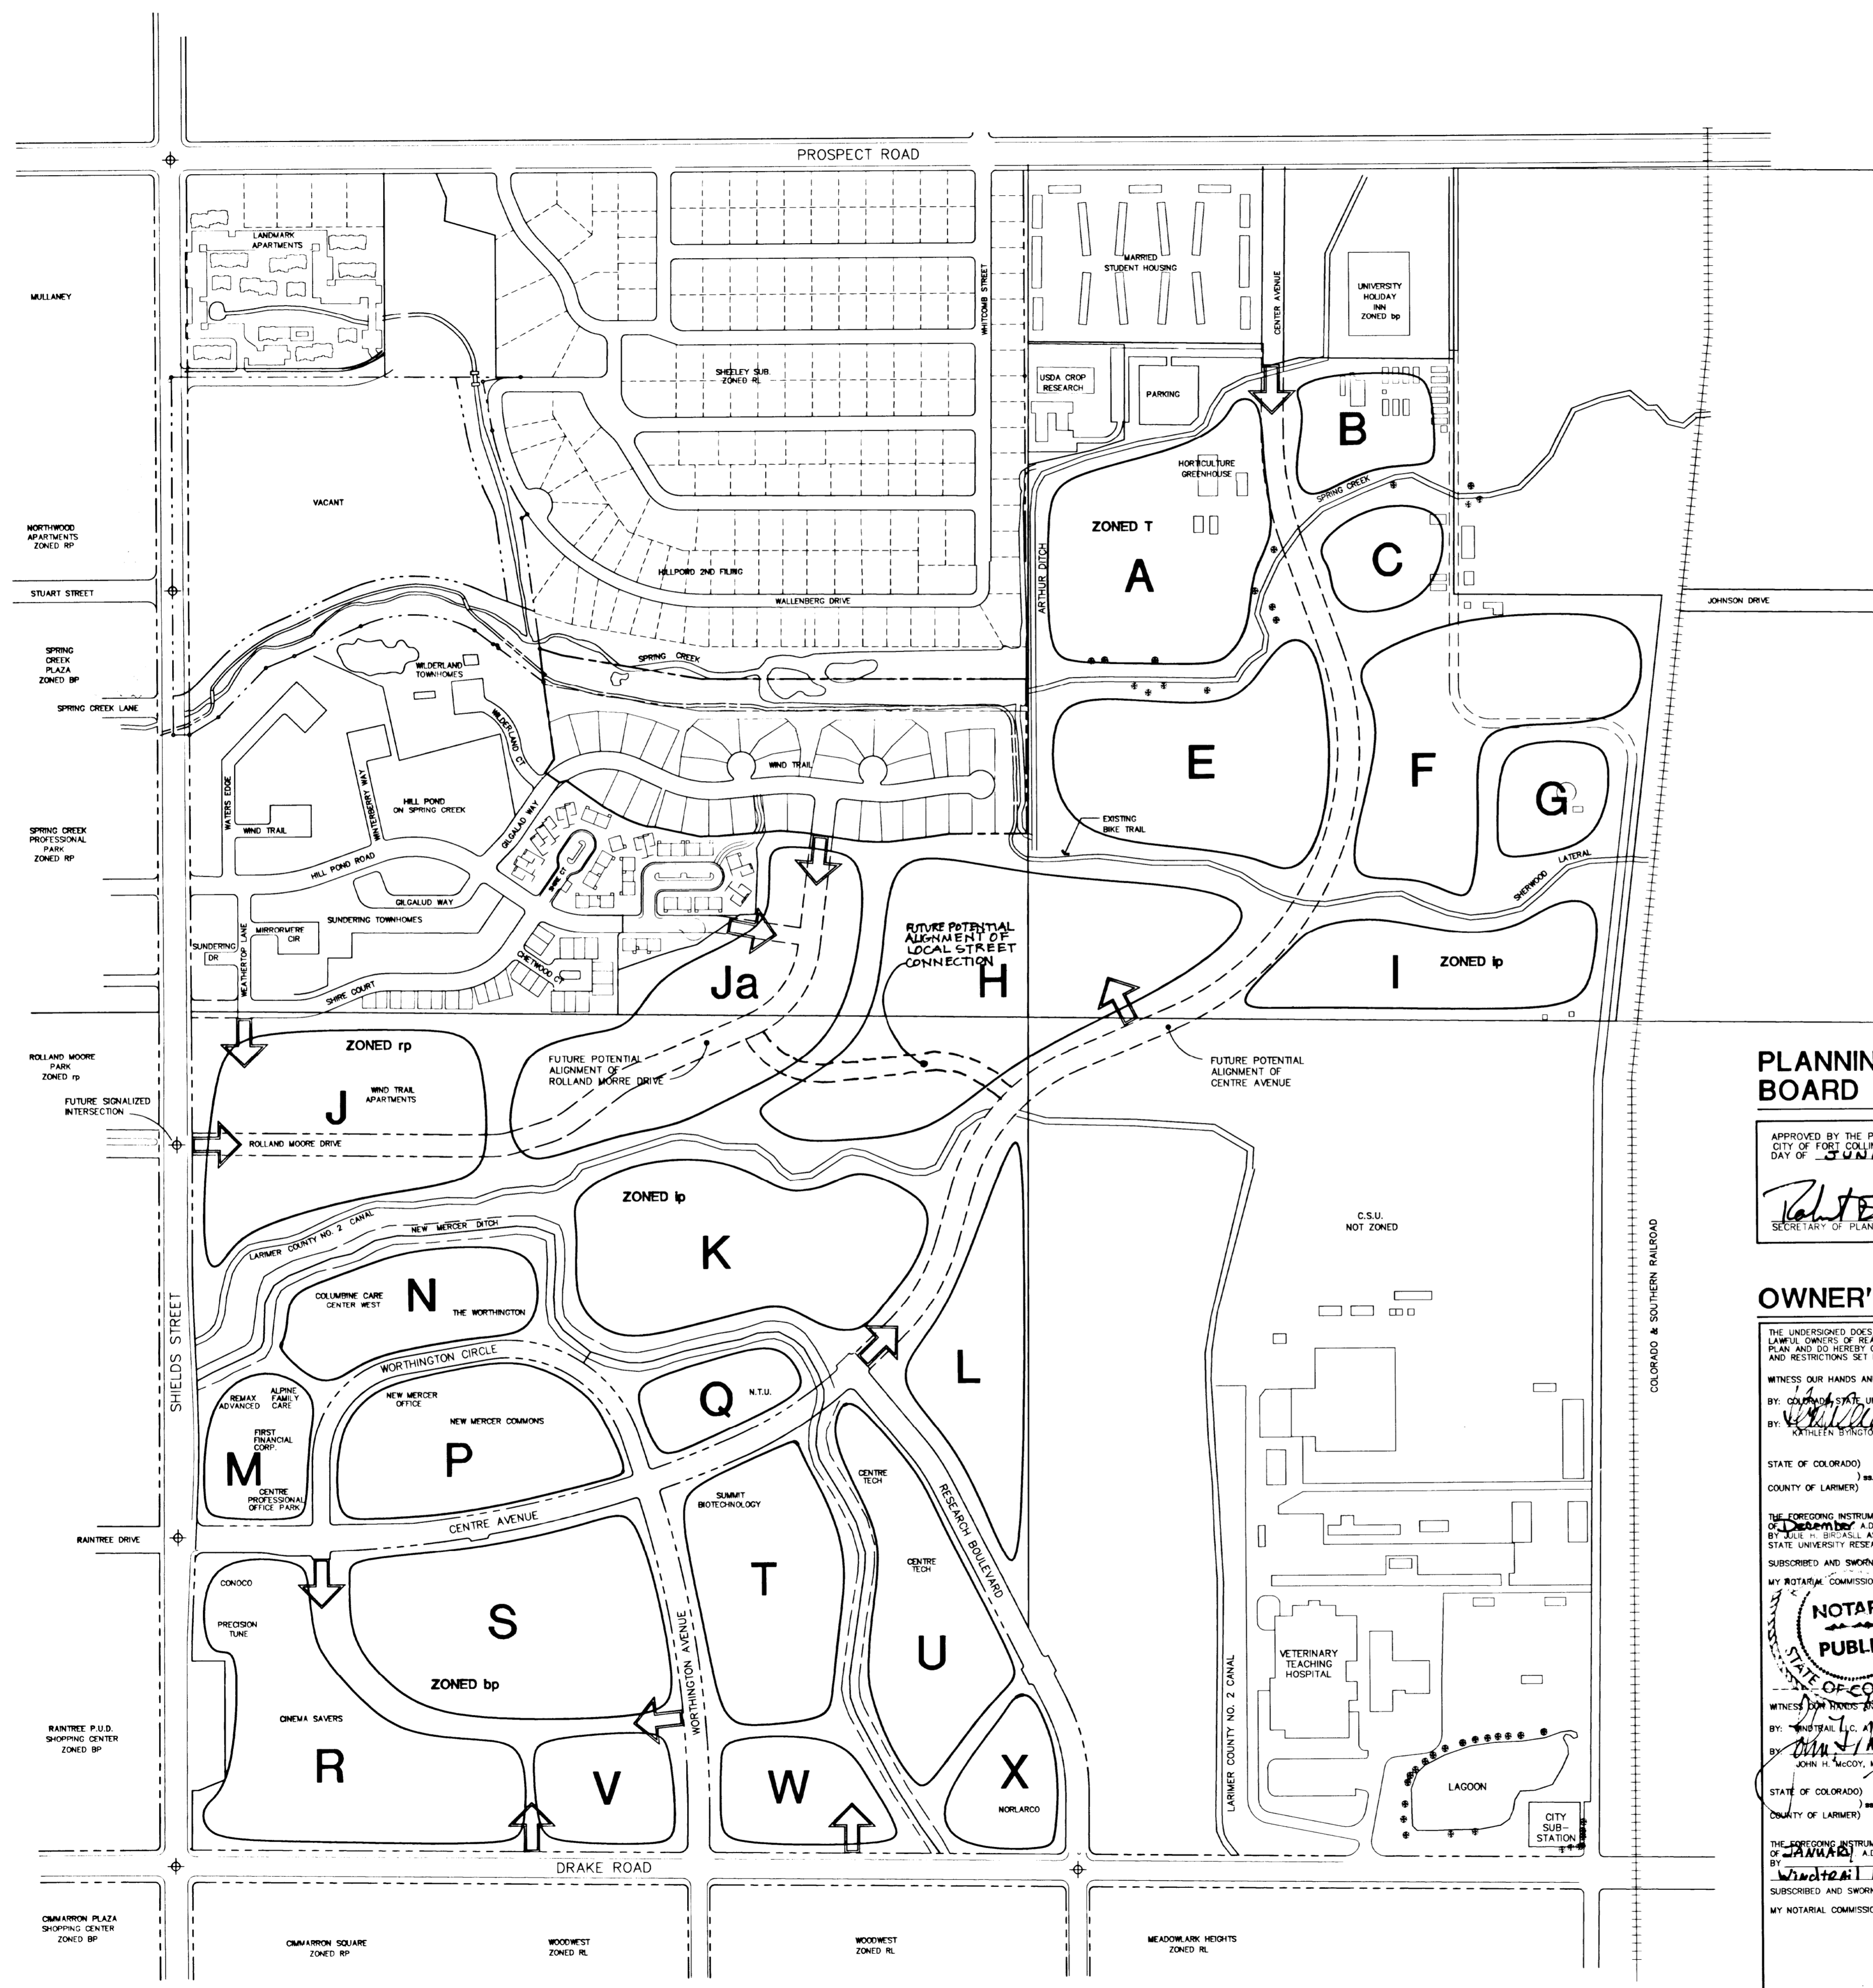
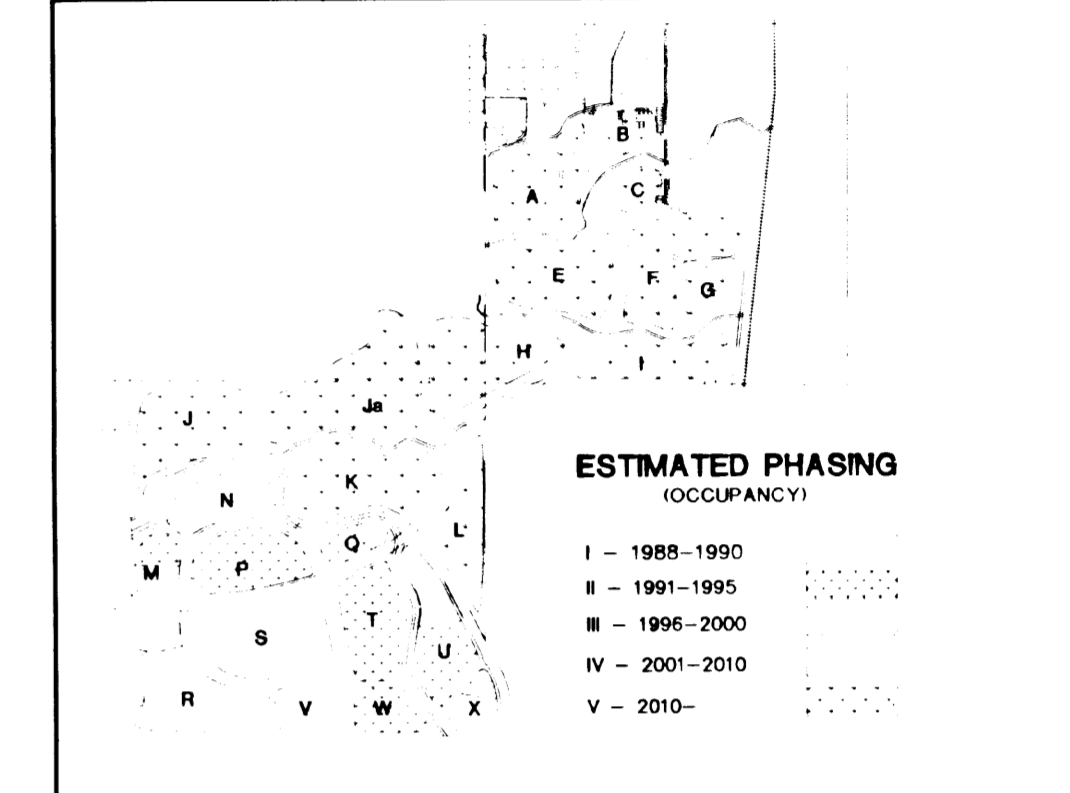


### GENERAL NOTES

1. THE PROPOSED LAND USES AND DENSITIES SHOWN ON THIS PLAN ARE ESTIMATES OF DEVELOPMENT POTENTIAL. APPROVAL OF THIS SITE PLAN BY THE CITY DOES NOT GUARANTEE ANY FUTURE LAND USES MUST BE APPROVED ACCORDING TO THE PROCEDURES, POLICIES, AND ORDINANCES OF THE PLANNED UNIT DEVELOPMENT REGULATIONS AND OTHER RELEVANT CITY POLICIES AND STANDARDS.
2. ALL PUBLIC STREETS AND PRIVATE DRIVEWAYS SHALL MEET THE CITY ENGINEER'S REQUIREMENTS, UNLESS SPECIFIC VARIANCES ARE GRANTED PRIOR TO DEVELOPMENT.
3. MAXIMUM BUILDING HEIGHT IS 40'.
4. LAND AREA ESTIMATES ARE APPROXIMATIONS. GROSS AREA IS CALCULATED TO THE CENTERLINE OF SURROUNDING STREETS. NET AREA IS CALCULATED LESS THE STREET RIGHTS-OF-WAY.
5. THE CENTRE FOR ADVANCED TECHNOLOGY IS PROPOSED TO BE A MIXED USE DEVELOPMENT WITH AN EMPHASIS ON "HIGH-TECH" (INDUSTRIAL, OFFICE, RESEARCH AND DEVELOPMENT) AND OTHER USES WITH A DIRECT RELATIONSHIP TO COLORADO STATE UNIVERSITY. THESE USES ARE INTENDED TO BE SUPPLEMENTED WITH RETAIL, RESIDENTIAL, HUMAN SERVICE, AND RECREATIONAL USES. THE LAND USE MIX REPRESENTED ON THIS OVERALL DEVELOPMENT PLAN IS A BEST ESTIMATE OF DEVELOPMENT POTENTIAL AT THIS TIME. AS CHANGES OCCUR IN THE MARKET PLACE, AS REQUIRED PUBLIC IMPROVEMENTS ARE DEFINED, AND AS DEVELOPMENT OF THE PROJECT CONTINUES, ADDITIONAL CHANGES TO THE LAND USE PROGRAM MAY BE REQUESTED.
6. NON-RESIDENTIAL LAND USE CATEGORIES INDICATED MAY INCLUDE THE FOLLOWING SPECIFIC USES:
  - HIGH-TECH USES
  - BIO-TECH USES
  - LIGHT INDUSTRIAL USES, INCLUDING THE MANUFACTURING OF ELECTRONIC INSTRUMENTS, ASSEMBLY, PACKAGING OR INSTALLATIONS OF ELECTRONIC INSTRUMENTS AND DEVICES WITH ENCLOSED COMPONENT STORAGE, PREPARATION OF FOOD PRODUCTS, PHARMACEUTICAL MANUFACTURING, RESEARCH AND SCIENTIFIC LABORATORIES, AND THE LIKE.
  - SUBJECT TO THE PERFORMANCE STANDARDS REQUIRED FOR THE RL LIMITED INDUSTRIAL DISTRICT:
    - GREENHOUSES AND RELATED RESEARCH FACILITIES
    - BANKS, SAVINGS AND LOANS, OR CREDIT UNIONS
    - RETAIL SHOPS / COMMERCIAL USES
    - INDOOR THEATERS
    - RESTAURANTS
    - HEALTH CLUBS AND / OR OTHER MEMBERSHIP CLUBS
    - HOTELS
    - MEDICAL CLINICS
    - HOSPITALS
    - OTHER HEALTHCARE FACILITIES AND CLINICS
    - PROFESSIONAL OFFICES
    - SIMILAR USES
7. OPENING OPEN SPACE AREAS - NOT INCLUDING OPEN SPACE AREAS OWNED BY THE CITY OF FORT COLLINS OR OTHER PUBLIC ENTITIES - ARE TO BE MAINTAINED BY AN OWNERS ASSOCIATION, OR OTHER APPROPRIATE VEHICLE DETERMINED AT THE TIME OF APPROVAL OF ADJACENT DEVELOPMENT.
8. AUTO RELATED AND ROADSIDE COMMERCIAL USES AS DEFINED IN THE LAND DEVELOPMENT GUIDANCE SYSTEM TO BE ALLOWED IN PARCELS "R", "V", AND "W".
9. RESIDENTIAL USES, AND PUBLIC OR PRIVATE COMMUNITY SERVICES, INCLUDING DAY CARE CENTERS, ARE TO BE ALLOWED AS ALTERNATIVE LAND USES IN ALL PARCELS.
10. EXACT LOCATION AND DESIGN OF STRUCTURES OVER 40' IN HEIGHT WILL BE CONSIDERED AT TIME OF SPECIFIC DEVELOPMENT PLAN REVIEW.

### VICINITY MAP

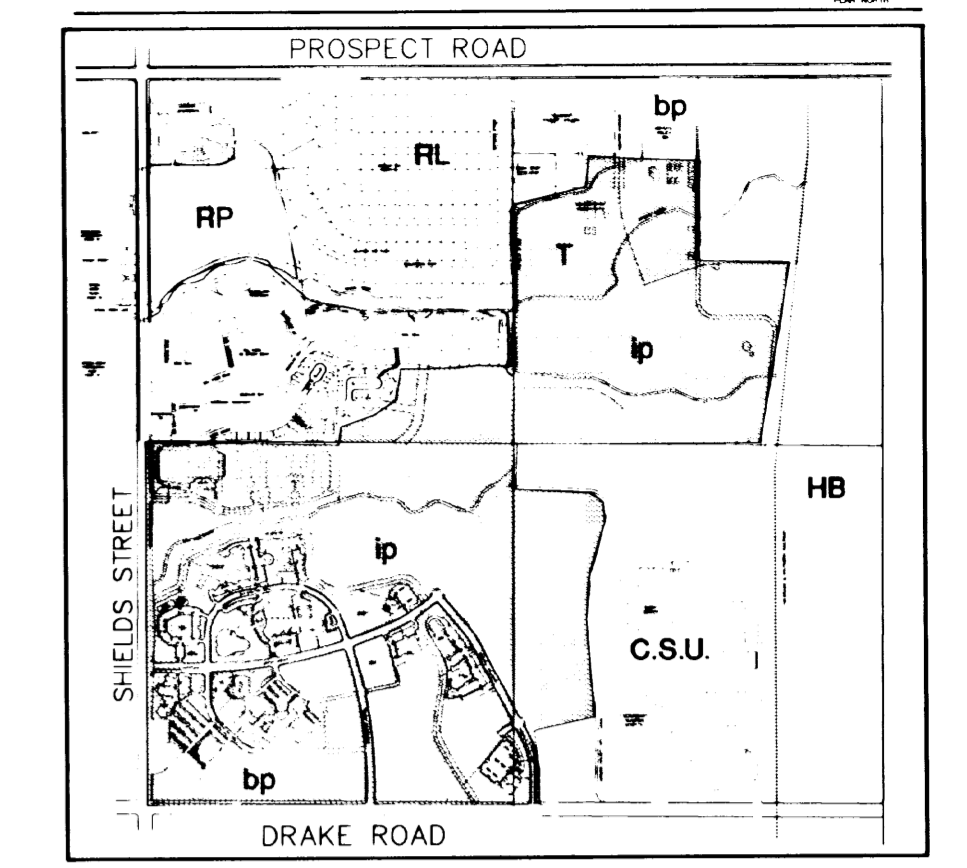

### LAND USE BREAKDOWN

PARCEL	LAND USE	NET AREA	DWELLING UNITS	DENSITY	APPROX. FLOOR AREA	NON-RESIDENTIAL FLOOR AREA RATIO
A	OPEN SPACE / RECREATION	10.2 AC				
B	OPEN SPACE / RECREATION	4.7 AC				
C	OPEN SPACE / RECREATION	4.2 AC				
D	N/A					
E	OPEN SPACE / RECREATION	15.4 AC				
F	OPEN SPACE / RECREATION	14.9 AC				
G	TRANSITIONAL	2.6 AC				
H	INDUSTRIAL/OFFICE/RM	24.3 AC			28,000 SQ.FT.	4.5 : 1
I	INDUSTRIAL/OFFICE/RM	9.8 AC			107,500 SQ.FT.	3.9 : 1
J	MIXED RESIDENTIAL	12.1 AC	77 UNITS	6.4 D.U. / AC		
K	MIXED RESIDENTIAL	13.1 AC	84 UNITS	6.4 D.U. / AC		
L	INDUSTRIAL/OFFICE/RM	15.8 AC			170,000 SQ.FT.	4.0 : 1
M	INDUSTRIAL/OFFICE/RM	8.5 AC			92,000 SQ.FT.	4.0 : 1
N	OFFICE	4.0 AC			54,000 SQ.FT.	3.2 : 1
O	ELDERLY HOUSING/HEALTH CARE / MULTIFAMILY	7.0 AC	300 UNITS	42.9 D.U. / AC		
P	RESIDENTIAL	9.0 AC	182 UNITS	18.0 D.U. / AC		
Q	INDUSTRIAL/OFFICE	4.1 AC			50,000 SQ.FT.	3.8 : 1
R	RETAIL & AUTO-RELATED	16.0 AC			155,000 SQ.FT.	4.5 : 1
S	INDUSTRIAL/OFFICE/RETAIL	12.8 AC			150,000 SQ.FT.	3.7 : 1
T	INDUSTRIAL/OFFICE/RM	10.5 AC			132,000 SQ.FT.	3.5 : 1
U	INDUSTRIAL/OFFICE/RM	9.7 AC			130,000 SQ.FT.	3.3 : 1
V	RETAIL & AUTO-RELATED	4.0 AC			45,000 SQ.FT.	3.9 : 1
W	COMMERCIAL/OFFICE/AUTO-RELATED	5.0 AC			55,000 SQ.FT.	4.0 : 1
X	FINANCIAL/OFFICE/RM	3.8 AC			50,000 SQ.FT.	3.3 : 1
	EXISTING PARKING AT BAY FARM	2.4 AC				
	OTHER OPEN SPACE	3.3 AC				
	STREET RIGHT-OF-WAY	17.6 AC				
<b>TOTAL</b>		<b>244.6 AC</b>	<b>623 UNITS</b>		<b>1,547,000 SQ.FT.</b>	

### PLANNING AND ZONING BOARD APPROVAL


*Robert Blanchard*  
SECRETARY OF PLANNING AND ZONING BOARD



### OWNER'S CERTIFICATION

THE UNDERSIGNED DOES/DO HEREBY CERTIFY THAT I/WE ARE THE LEGAL OWNER(S) OF REAL PROPERTY DESCRIBED ON THIS SITE PLAN AND DO HEREBY CERTIFY THAT I/WE ACCEPT THE CONDITIONS AND RESTRICTIONS SET FORTH ON SAID SITE PLAN.

WITNESS OUR HANDS AND SEAL THIS 31<sup>ST</sup> DAY OF December, 1993.


STATE OF COLORADO)  
COUNTY OF LARIMER)


SUBSCRIBED AND SWORN BEFORE ME THIS 31<sup>ST</sup> DAY OF December A.D., 1993 MY NOTARIAL COMMISSION EXPIRES 3-12-97.

*Sharon Hobbins*  
NOTARY PUBLIC  
202 Adams, C.S.U.  
Ft. Collins, CO 80525  
CITY, STATE, ZIP CODE

WITNESS MY HAND AND SEAL THIS 7<sup>TH</sup> DAY OF January A.D., 1994.

BY: *John H. McCoy*  
JOHN H. MCCOY, MEMBER

STATE OF COLORADO)  
COUNTY OF LARIMER)

THE FOREGOING INSTRUMENT WAS ACKNOWLEDGED BEFORE ME THIS 7<sup>TH</sup> DAY OF January A.D., 1994 BY WINDTRAIL LLC AS COORDINATOR SECRETARY / TREASURER, FOR COLORADO STATE UNIVERSITY RESEARCH FOUNDATION.

SUBSCRIBED AND SWORN BEFORE ME THIS 7<sup>TH</sup> DAY OF January A.D., 1994 MY NOTARIAL COMMISSION EXPIRES 4-9-2000.

*Don Davis*  
NOTARY PUBLIC  
711 Tracey Plwy  
Ft. Collins, CO 80524  
CITY, STATE, ZIP CODE

## AMENDED OVERALL DEVELOPMENT PLAN

# CENTRE FOR ADVANCED TECHNOLOGY

FORT COLLINS COLORADO  
INCLUDING A PORTION OF WINDTRAIL ON SPRING CREEK O.D.P.



DATE: 5 / 2 / 94  
JOB NO.: 94-23  
DRAWN: CM  
CHECKED:  
REVISED:

